


T.8S.R.2W.W.M.

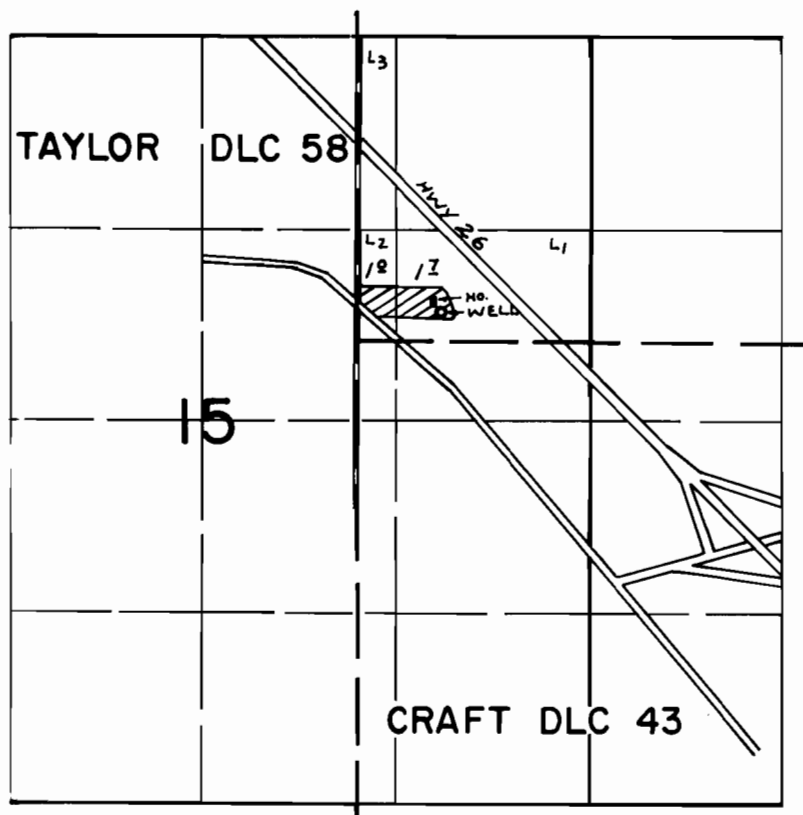

WELL LOC: 200' N. & 580' E. FROM N.W. COR. DLC 43

**FINAL PROOF SURVEY**  
UNDER

Application No. G-6288 Permit No. G-5917  
IN NAME OF

BUD W. KLAGGE

Surveyed AUG 4 1976, by R. MUCKEN