


# T. 6 S., R. 3 W., W. M.

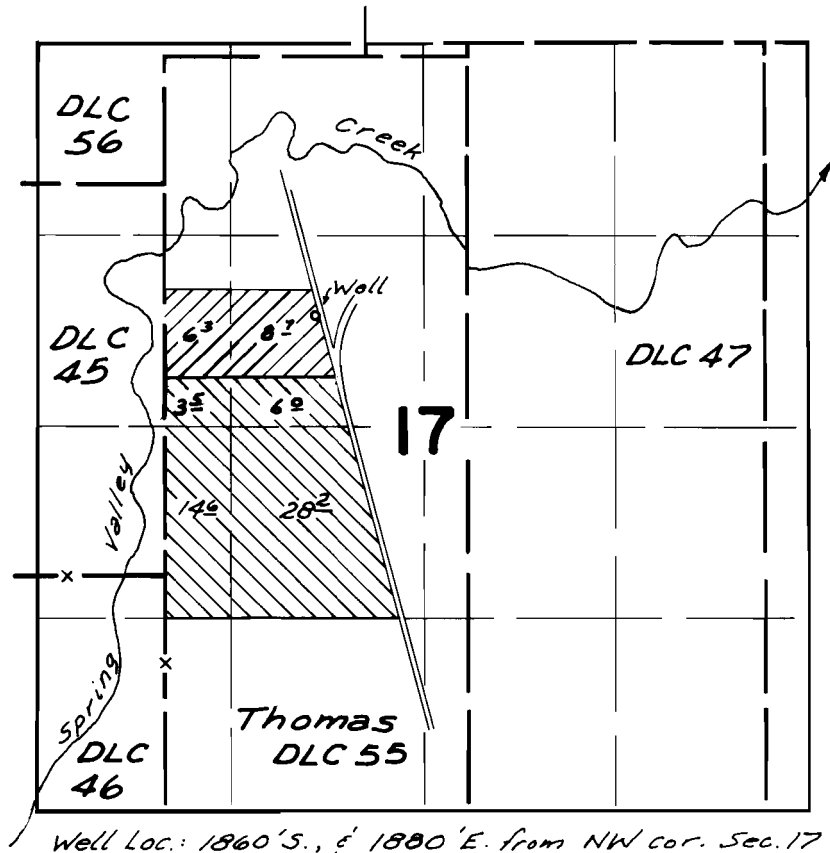

Suppl  
 Primary

## FINAL PROOF SURVEY UNDER

Application No. G-6280 Permit No. G-5911  
IN NAME OF

Sidney Van Dyke

Surveyed Oct 22, 1976 by D. M. Norby