


T.2S.,R.10W.,W.M.

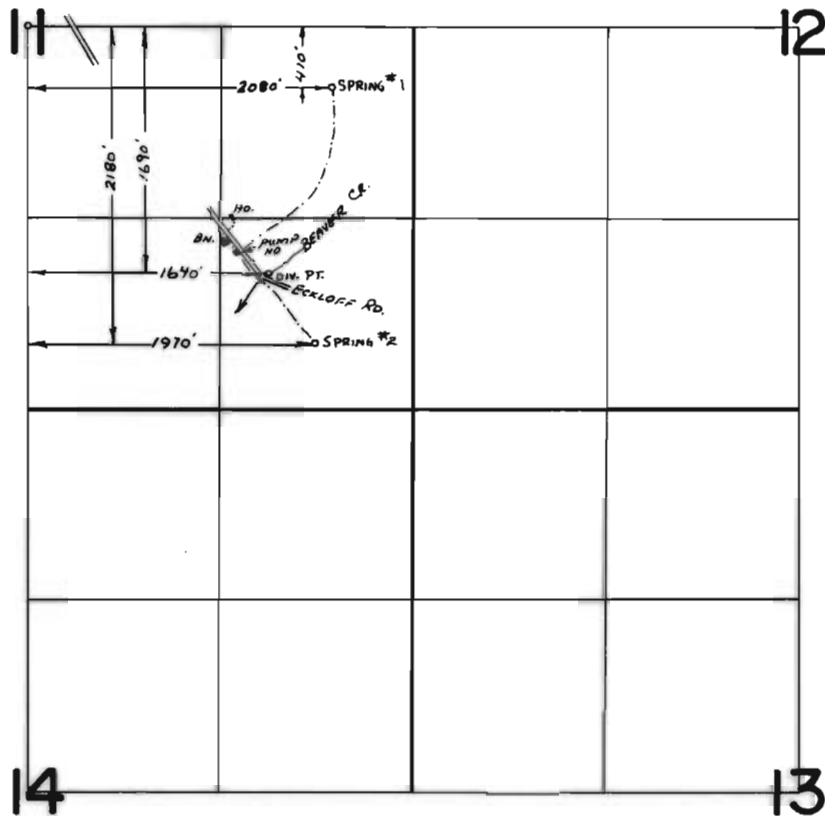

FINAL PROOF SURVEY
UNDER

Application No. 48135 Permit No. 36142...
IN NAME OF

CHARLES R. & ANITA J. NEILSON

Surveyed JUNE 30 1976 by L. T. ...