


# T. 2 S., R. 38 E., W. M.

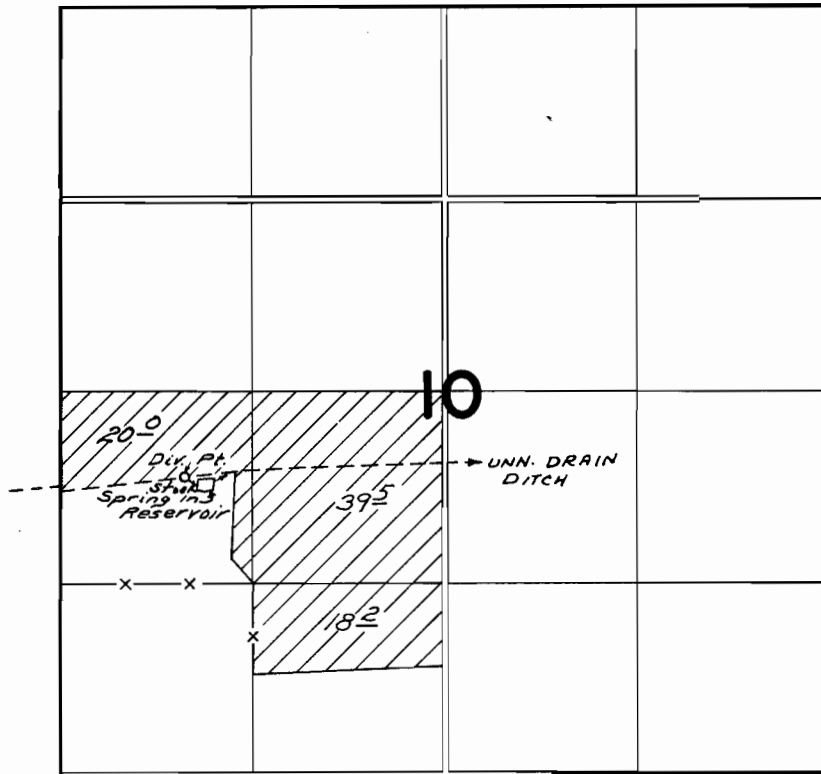

DIV. LOC: DITCH - 590'S. & 850'E. from W 1/4 Cor. Sec. 10  
SPRING & RES. - 650'S & 950' E from W 1/4 Cor. Sec. 10

## FINAL PROOF SURVEY UNDER

51629                      38827  
Application No. R-51816 Permit No. R-6242  
IN NAME OF

*David C. & Mary H. Nichols*

Surveyed Sept. 27, 1976, by D.M. Norby