


T. 2 S., R. 38 E., W. M.

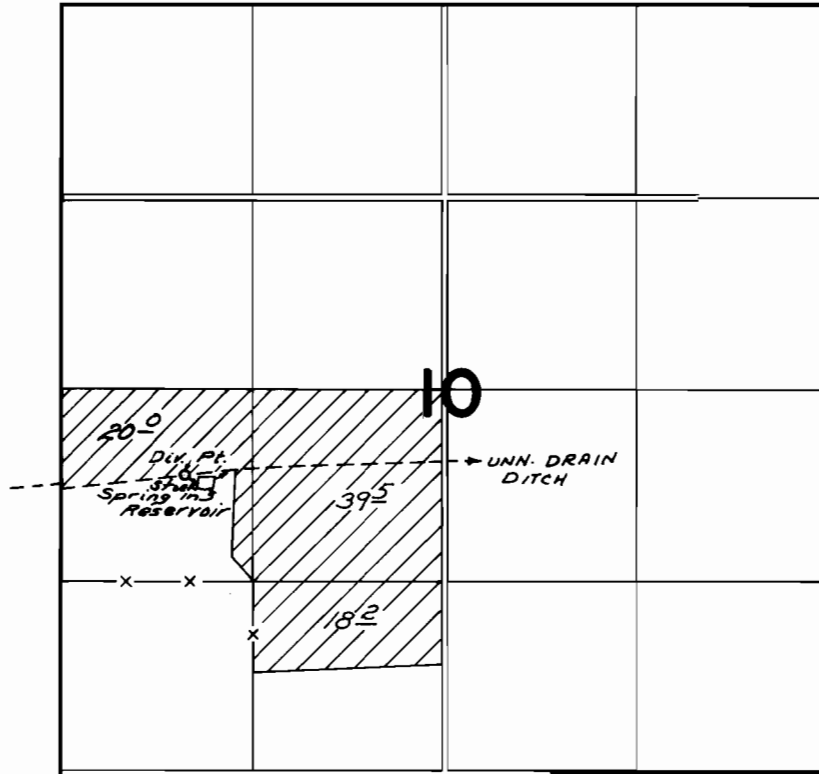

DIV. LOC: DITCH - 590'S. & 850'E. from W 1/4 Cor. Sec. 10
SPRING & RES. - 650'S & 950'E from W 1/4 Cor. Sec. 10

FINAL PROOF SURVEY UNDER

51629 38827
Application No. R-51816 Permit No. R-6242
IN NAME OF

David C. & Mary H. Nichols

Surveyed Sept. 27, 1976 by D.M. Norby