


P# 6-2127

T.2N.R.13E.W.M.

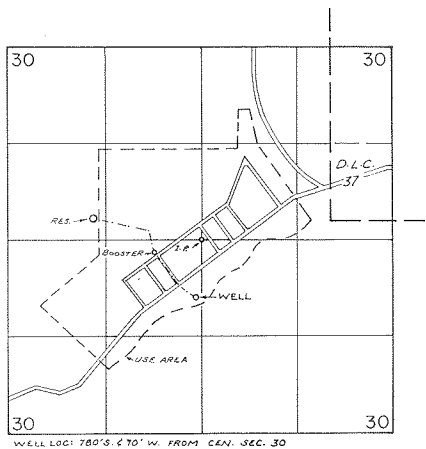

FINAL PROOF SURVEY UNDER

Application No. G-2307.. Permit No. G-2127..
IN NAME OF

LOWER CHENQUITH WATER DISTRICT

Surveyed APR. 6. 1976., by R. MUCKEN