


Frdrick C. and Peggy C. Clausen
John F. and Patricia R. Clausen

Rt 2 Box 14

Dufur, Oregon 97021

36751
RECEIVED
JAN 30 1973
STATE ENGINEER
SALEM, OREGON

SE 1/4 Sec. 25 T1S R14E W.M.

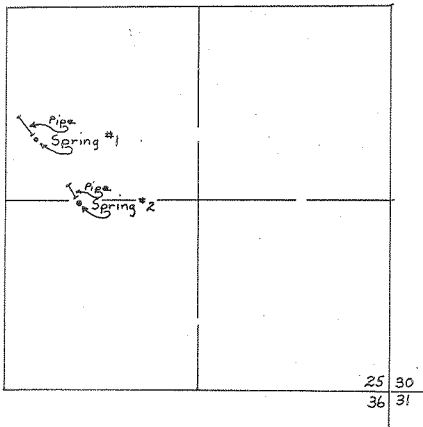

Spring No.1 located 900' South and 200' East of the NW
Corner of the SE 1/4 of Sec. 25

Spring No.2 located 1330' South and 500' East of the
NW Corner of the SE 1/4 of Sec. 25

Scale: 8" = 1 mile

Application No. 50019

Permit No. 36951