


T.1N.R.4.W.W.M.

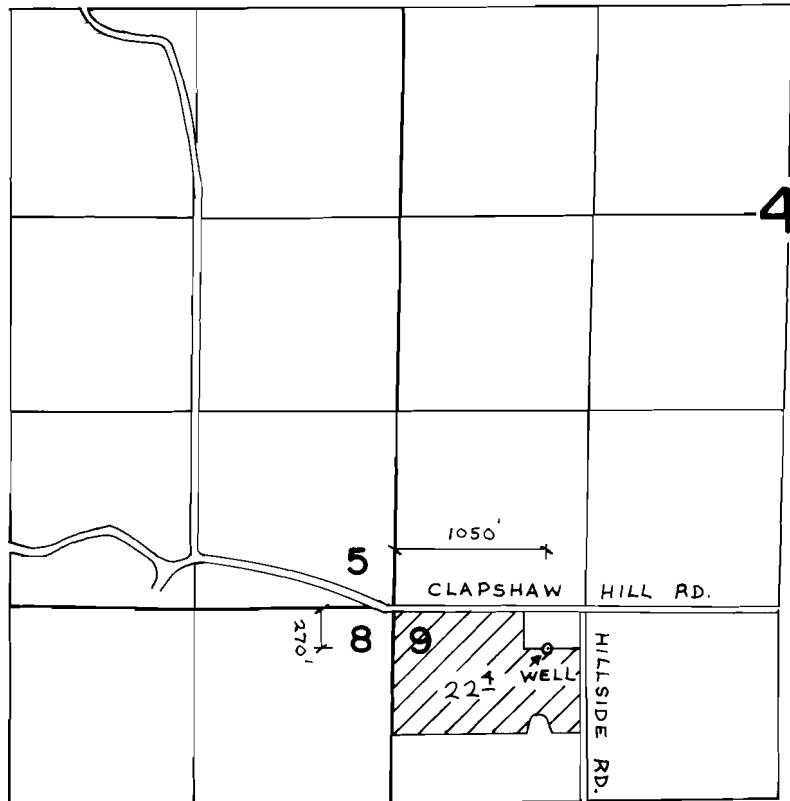

FINAL PROOF SURVEY UNDER

Application No. G-5381 Permit No. G-5312
IN NAME OF
DWAYNE HEIKES

Surveyed May 18 1976, by R.G. Mucken