


T. 1 N. R. 4 W., W.M.

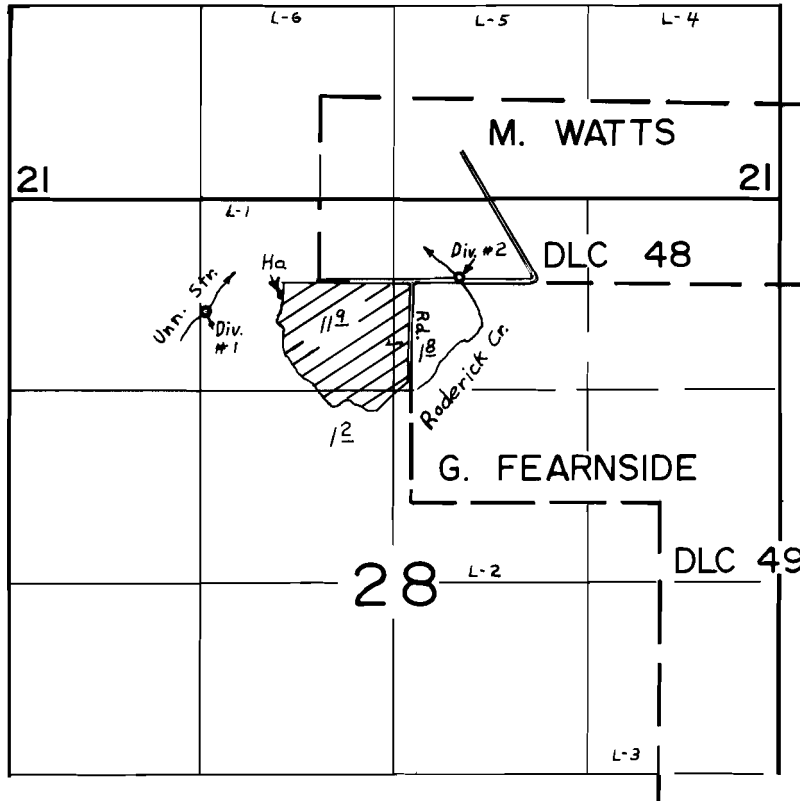

Div. #1 - 200' S. & 1400' W. ; #2 - 20' N. & 330' W. , BOTH FROM N.W. COR. FEARNSIDE D.L.C. 49

FINAL PROOF SURVEY UNDER

Application No. 44359... Permit No. 33140...
IN NAME OF

..... HAROLD DAN FRENCH

Surveyed MAY 19 1976, by R.G. MUCKEN...