


T. 1N. R. 4W. W.M.

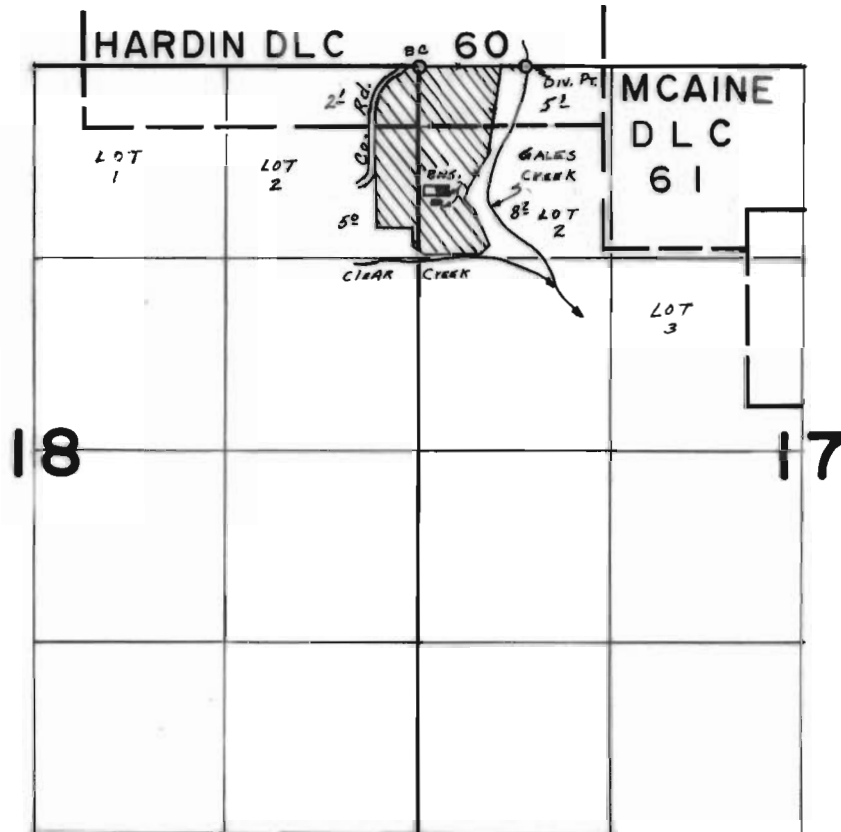

DIV. PT. 720' E. from NW Cor. Sec 17.

FINAL PROOF SURVEY UNDER

Application No. 48704 Permit No. 36544
IN NAME OF

WILLIAM EVAN GILDOW

Surveyed Oct. 27 1977, by S.C. BROWN