



T.1N. R.4W. W.M.

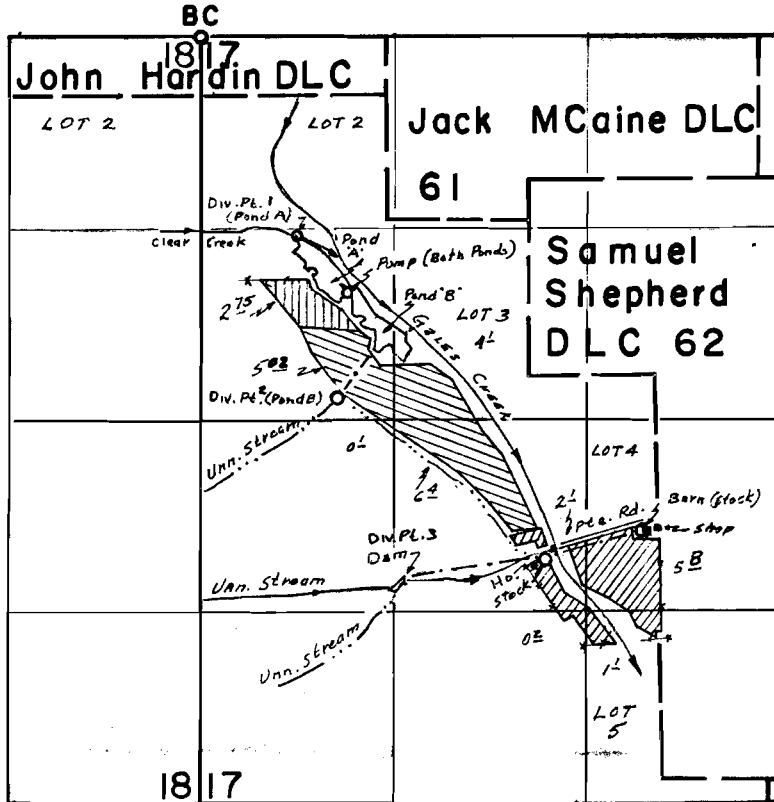

Div. Pt. 1 - Clear Creek - 1360'S. & 620'E. from NW Cor. Sec. 17
 Div. Pt. 2 - Unn. Str. - 2450'S. & 925'E. from NW Cor. Sec. 17
 Div. Pt. 3 - Unn. Str. - 1180'S. & 1355'E. from NW Cor. SW 1/4 Sec. 17

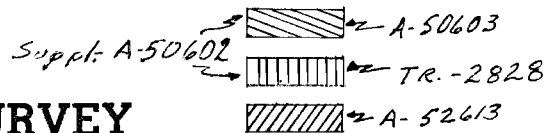

FINAL PROOF SURVEY

TRANSFER No. 2828

52613 39821
 50600 R-6177
 50601 R-6178
 50602 38240

Application No. 50603... Permit No. 38241....

IN NAME OF

Melvin & Iris Howell

Surveyed OCT. 26 1977, by S.C. BROWN.....