



# T.1N. R.4W. W.M.

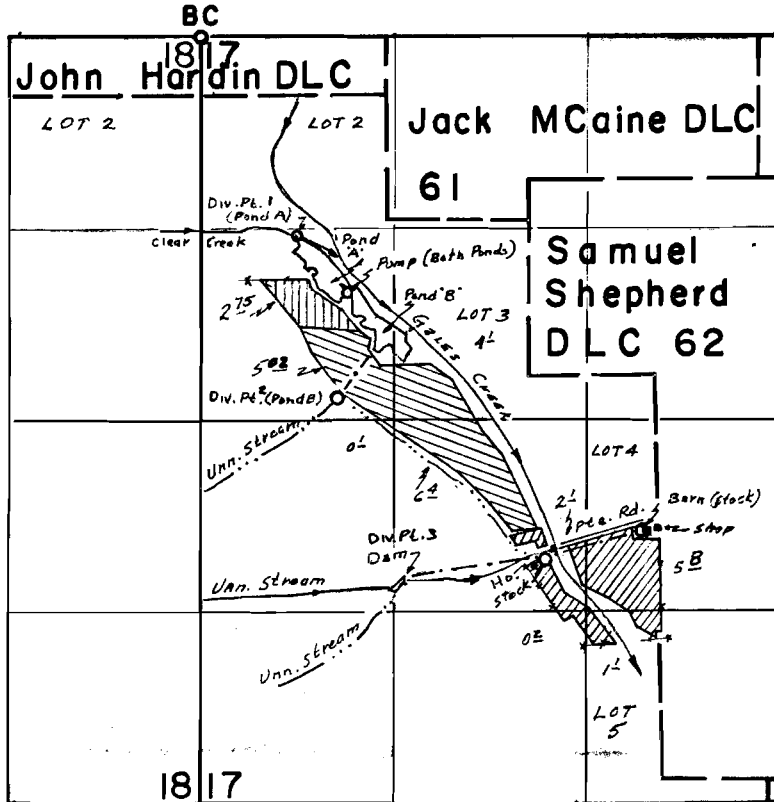

Div. Pt. 1 - Clear Creek - 1360'S. & 620'E. from NW Cor. Sec. 17  
 Div. Pt. 2 - Unn. Str. - 2450'S. & 925'E. from NW Cor. Sec. 17  
 Div. Pt. 3 - Unn. Str. - 1180'S. & 1355'E. from NW Cor. SW 1/4 Sec. 17

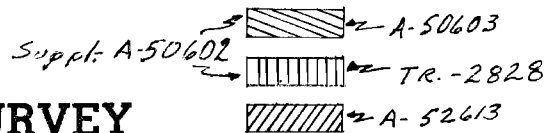

## FINAL PROOF SURVEY

TRANSFER No. 2828

52613                      39821  
 50600                      R-6177  
 50601                      R-6178  
 50602                      38240

Application No. 50603..... Permit No. 38241.....

IN NAME OF

Melvin & Iris Howell

Surveyed OCT. 26 1977, by S.C. BROWN.....