RECEIVED
SEP 6 1974
STATE ENGINEER
SALEM, OREGON

T.1S.R.4.W.W.M.

RECEIVED
DEC 19 1974
STATE ENGINEER
SALEM, OREGON

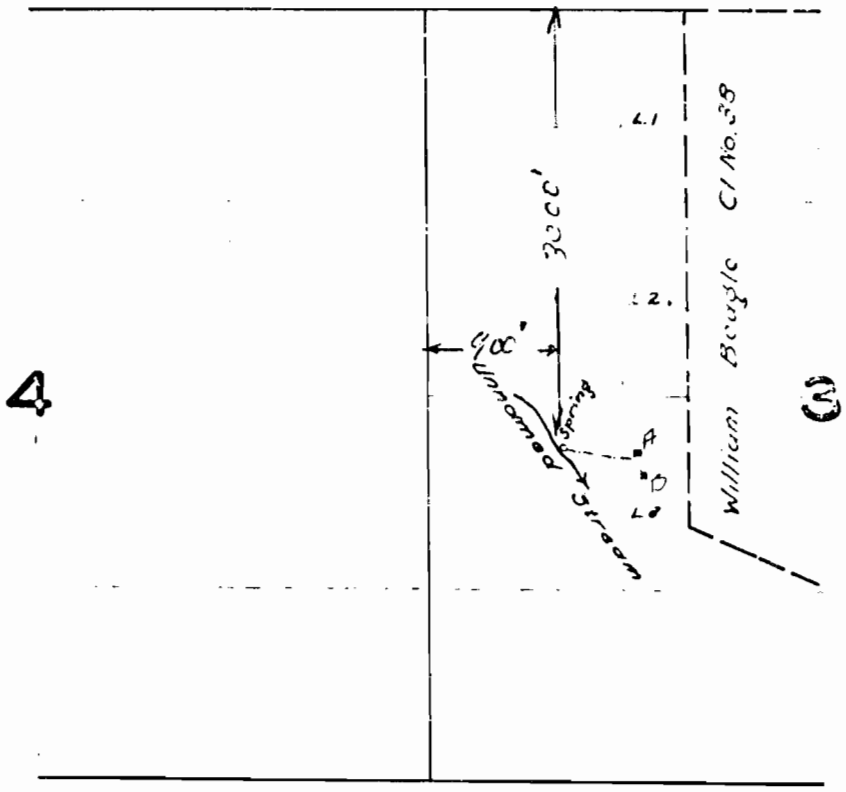

RECEIVED
FEB 6 1975
STATE ENGINEER
SALEM, OREGON

Item "A" is the dwelling covered by the original water right Certificate in Volumbe 14, page 20109
Item "B" is the dwelling ~~xxx~~ (second) where the water flows from item A to item B.

FINAL PROOF SURVEY

UNDER

Application No. 24033 Permit No. 18947

IN NAME OF

ADAM MILES AUSTIN & ESTHER M. AUSTIN

Surveyed 4/17 1952, by H. L. CURTIN

Application No. 52388
Permit No. 39412