


T. 1 N. R. 2 W. W. M.

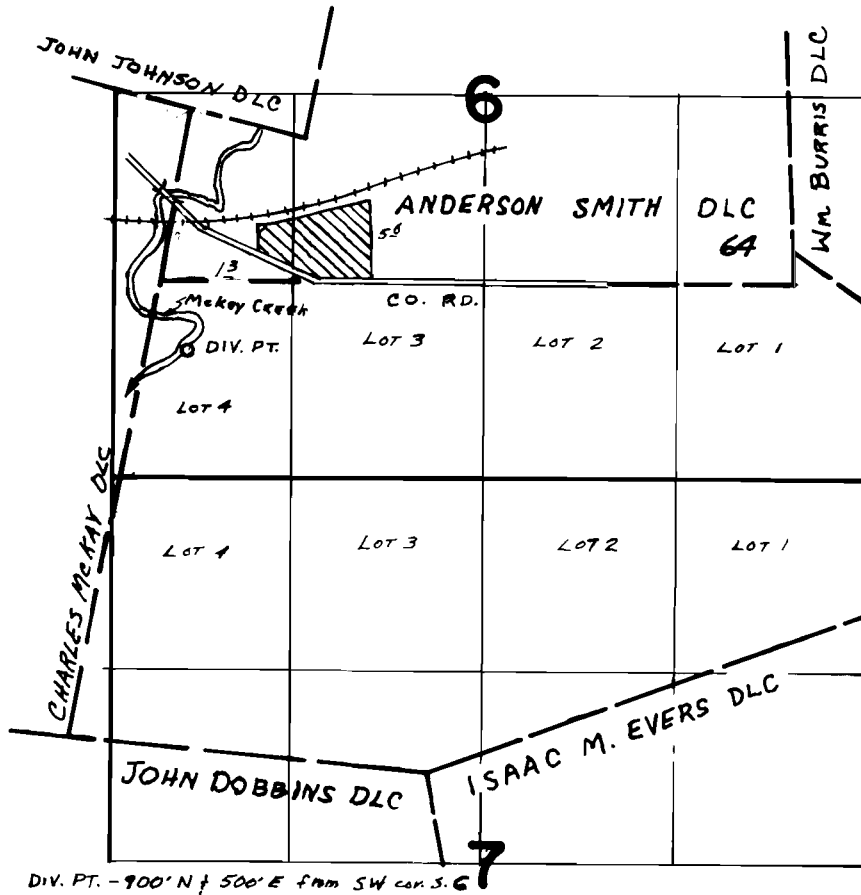

FINAL PROOF SURVEY UNDER

Application No. 53952 Permit No. 40245
IN NAME OF

FLOYD R. VAN DOMELEN.....

Surveyed Oct. 28 1977, by S. C. BROWN