


P. 26002
SUP. 30235
47232
122

T.8&9S.R.24&25E.W.M.

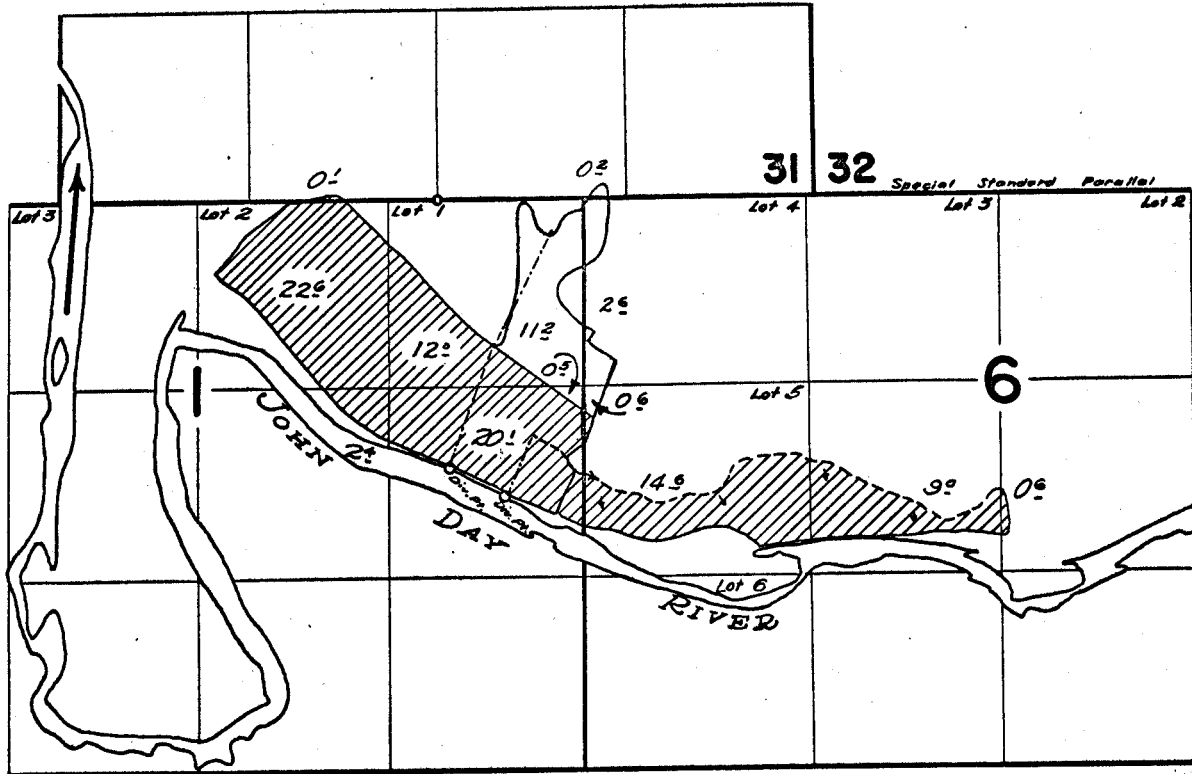

FINAL PROOF SURVEY UNDER

Application No. 32846.. Permit No. 26002.
IN NAME OF

..... WILLIAM I. CHAPMAN

Surveyed Oct...11... 1961., by C.O. Bartels.