


T. 3S. R. 2W. W.M.

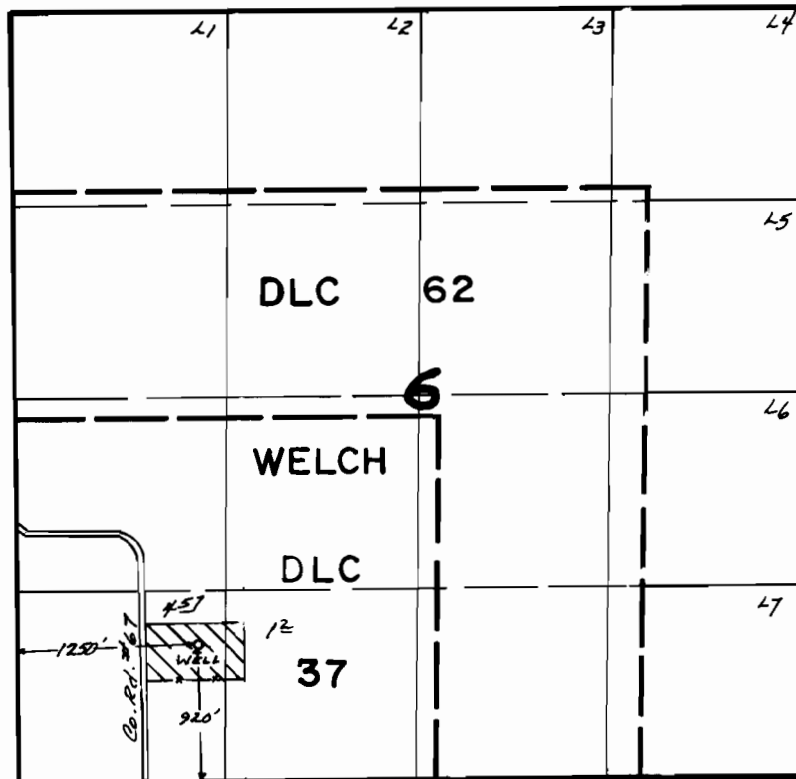

FINAL PROOF SURVEY
UNDER

Application No. G-7022.. Permit No. G-6516...
IN NAME OF

.....JAKOB TAEUBEL.....

Surveyed Sept. 8.... 1977., by S.C. BROWN.....