


# T.4S.,R.3&4W.,W.M.

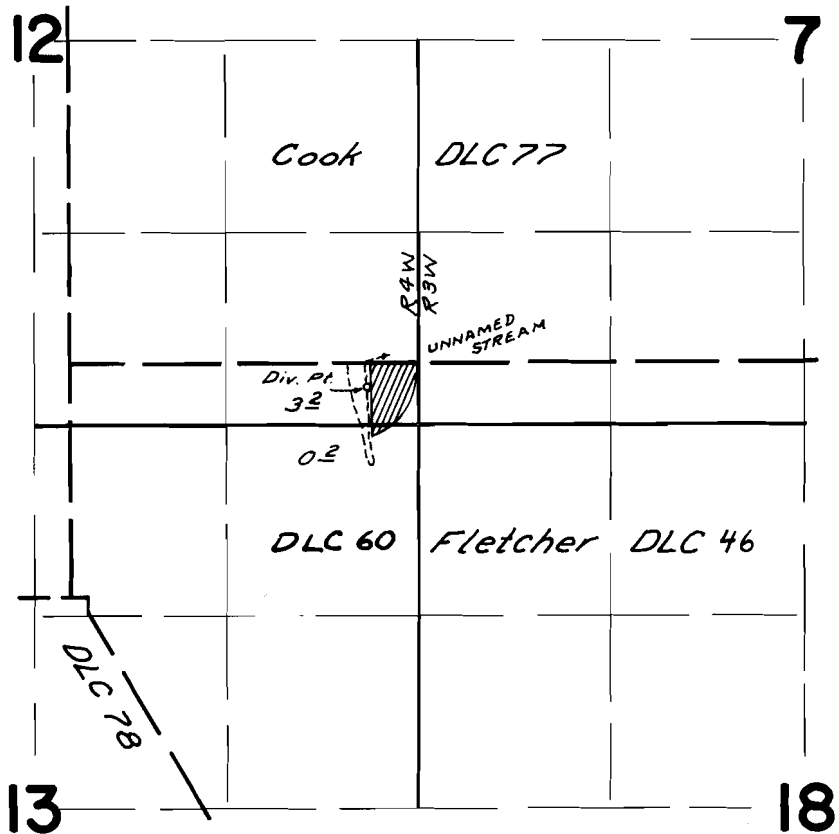

Div. Pt. Loc.: 270 A.N. & 350 A.W. from SE Cor. Sec. 12

## FINAL PROOF SURVEY UNDER

Application No. 50317 Permit No. 37990  
IN NAME OF

Wendellen L. Christenson

Surveyed June 3, 1976, by L. H. Nunn