


T.5S.R.4W.W.M.

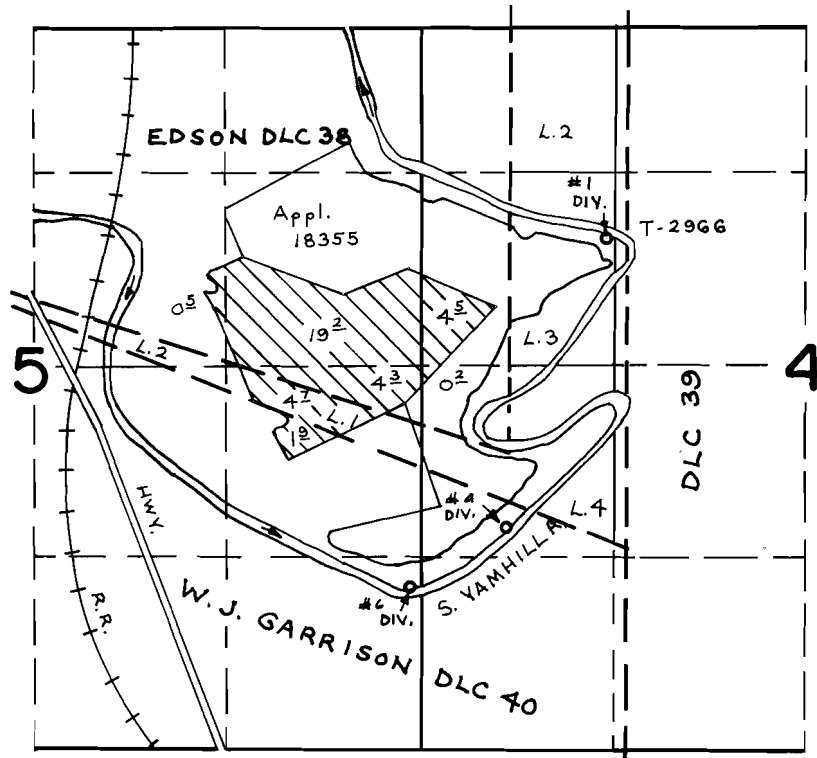

#1 DIV. LOC. - 1450' S. & 1260' E. FROM N.W. COR. SEC. 4
 #4 DIV. LOC. - 200' N. & 570' E. FROM S.W. COR. N.W. 1/4 S.W. 1/4 SEC. 4
 #6 DIV. LOC. - 200' S. & 70' W. FROM S.W. COR. N.W. 1/4 S.W. 1/4 SEC. 4

FINAL PROOF SURVEY UNDER

Transfer-2966

Application No. 50525 Permit No. 38152
 IN NAME OF

T. J. BOYER

Surveyed June 2 1976, by R.G. Mucken