



T. 5 S., R. 4 W., W.M.

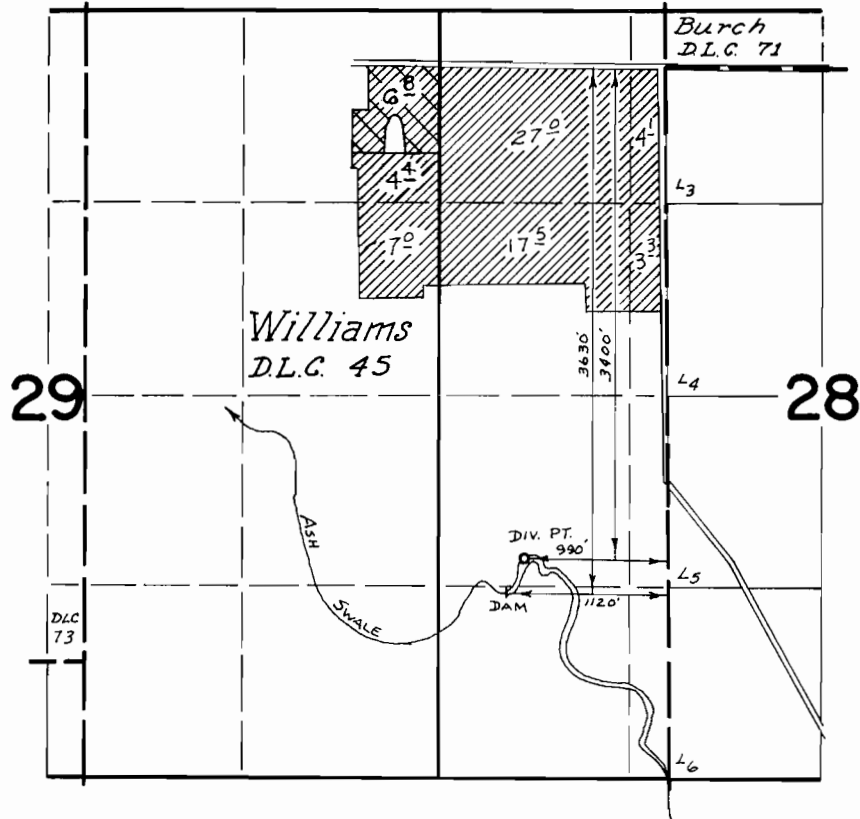

FINAL PROOF SURVEY UNDER

	51672	38535	
	40250	29822	
Application No.	47062	Permit No.	

IN NAME OF

ESTATE OF IVAN C. ROBISON

Surveyed May 15 1972 by D. Norby
June 7 1976 R.G. Mucken