


T.5S.R.6&7W. W.M.

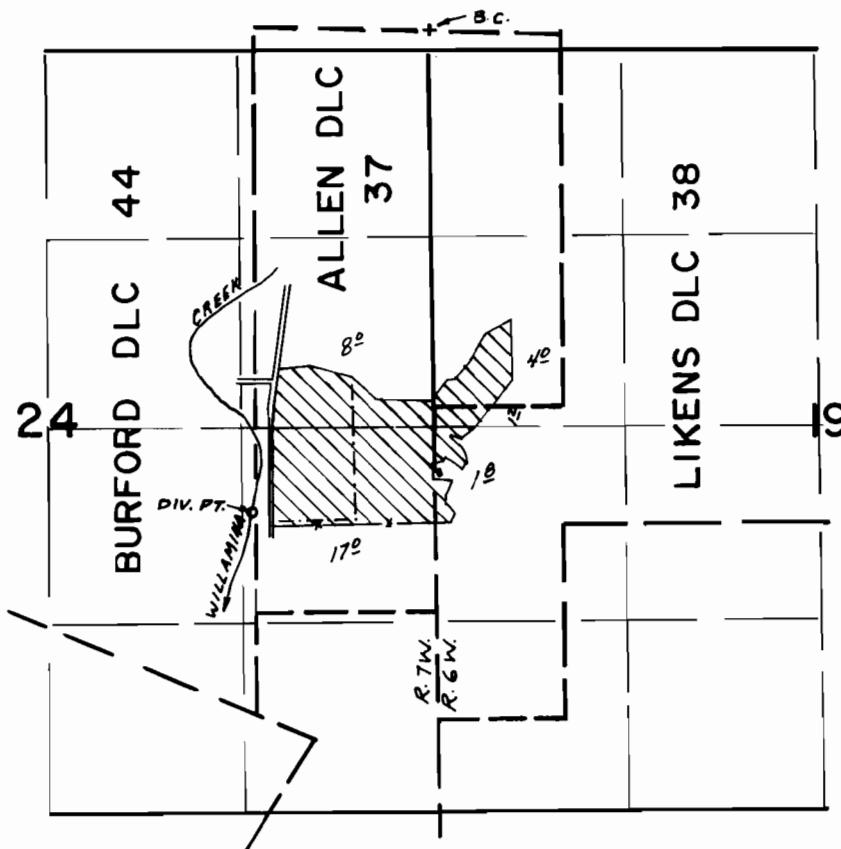

DIV. PT. LOC. - 2060' N & 1250' W FROM SE COR. SEC. 24

FINAL PROOF SURVEY UNDER

Application No. 51524. Permit No. 38880.
IN NAME OF

.....**HOWARD A. SCATES**.....

Surveyed Sept. 8, 1976, by L.H. NUNN.....