


T.3S., R.3W., W.M.

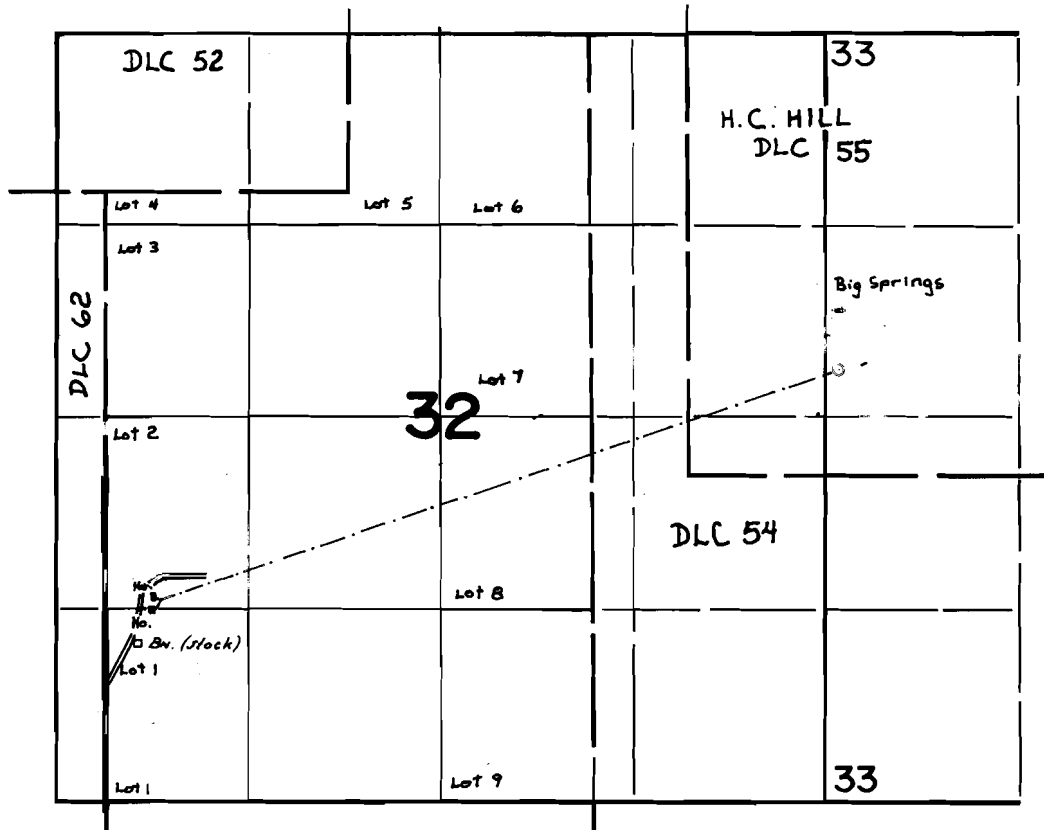

SPRING LOC. 320' N. & 80' E. FROM THE W 1/4 COR. SEC. 33.

FINAL PROOF SURVEY
UNDER

Application No. 53077 Permit No. 38769
IN NAME OF

CLAUDE W. & CAROL L. BISSONETTE

Surveyed APRIL 16 1976, by L.H. NUNN