


T.5S., R.7W., W.M.

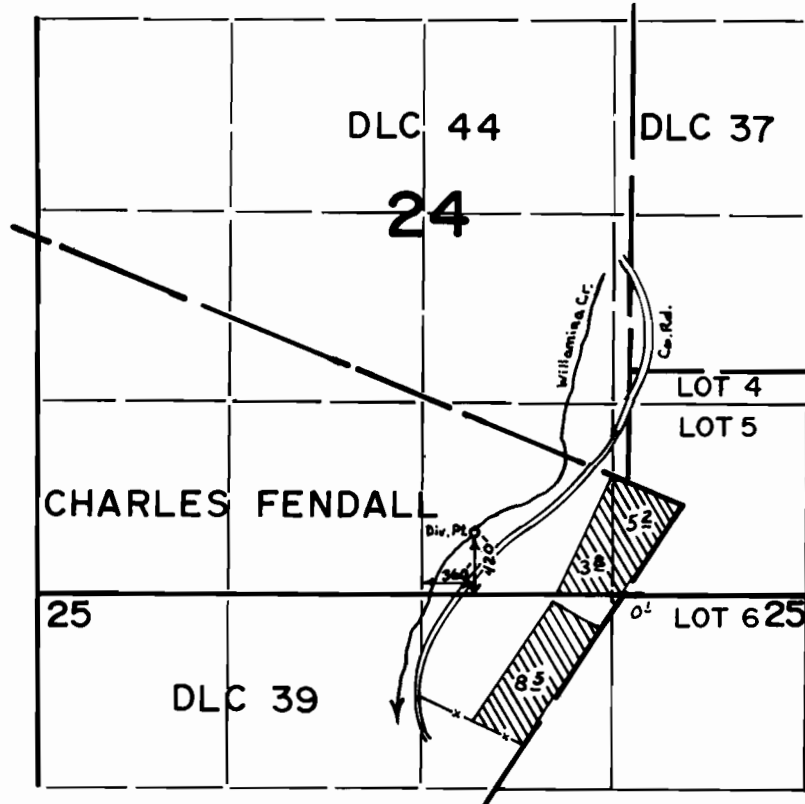

FINAL PROOF SURVEY UNDER

Application No. 52977 Permit No. 39993
IN NAME OF

BENNETT H. ALLEN

Surveyed AUG. 6 1976, by D. NORBY