


T5S. R8W. WM.

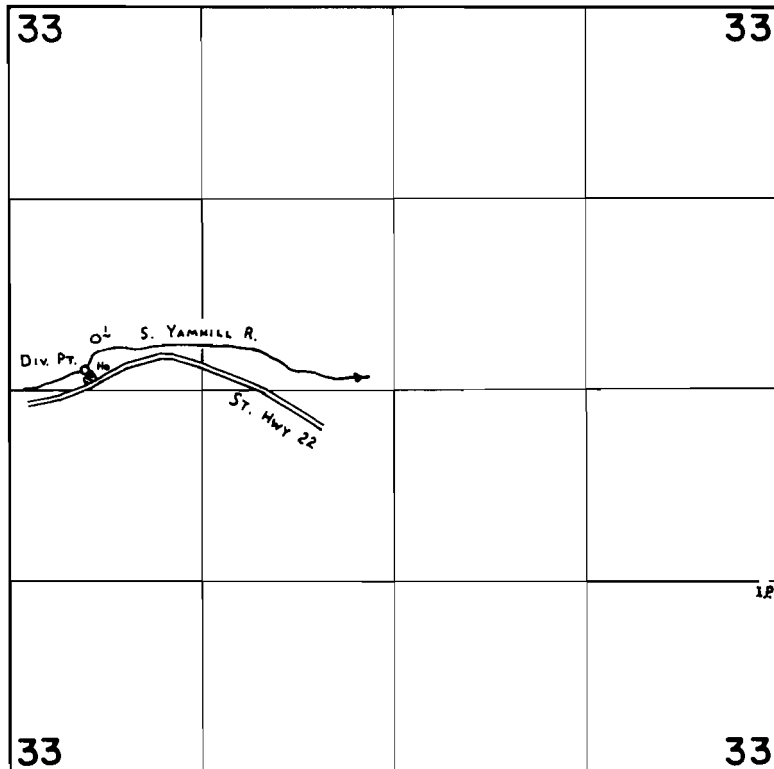

Div. Pt. Loc.: 140' N & 510' E fr. W ¼ Sec 33.

FINAL PROOF SURVEY UNDER

Application No. 53094 Permit No. 40041
IN NAME OF

HARRY A. & WELTHA I. TURNER

Surveyed SEPT. 7, 1978, by C. L. HUGHES