


T. 5S. R. 4 W.W.M.

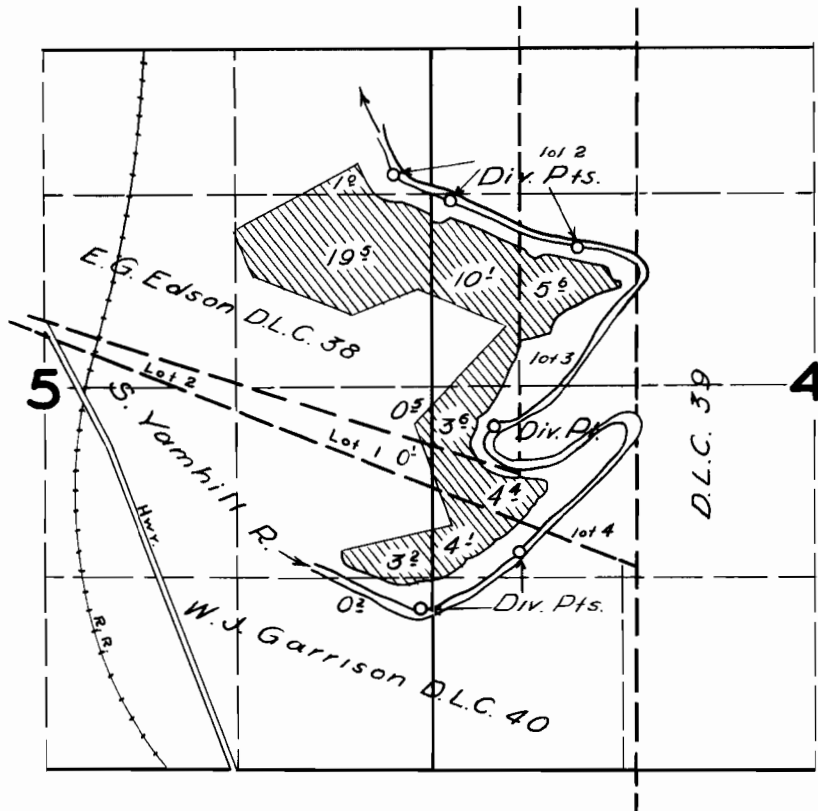

FINAL PROOF SURVEY
UNDER

Application No. 18355 Permit No. 13980
IN NAME OF

THEADORE J. & DOROTHEA M. BOYER

Surveyed 4 June 1957, by *[Signature]*