


T.12S.R.5W.W.M.

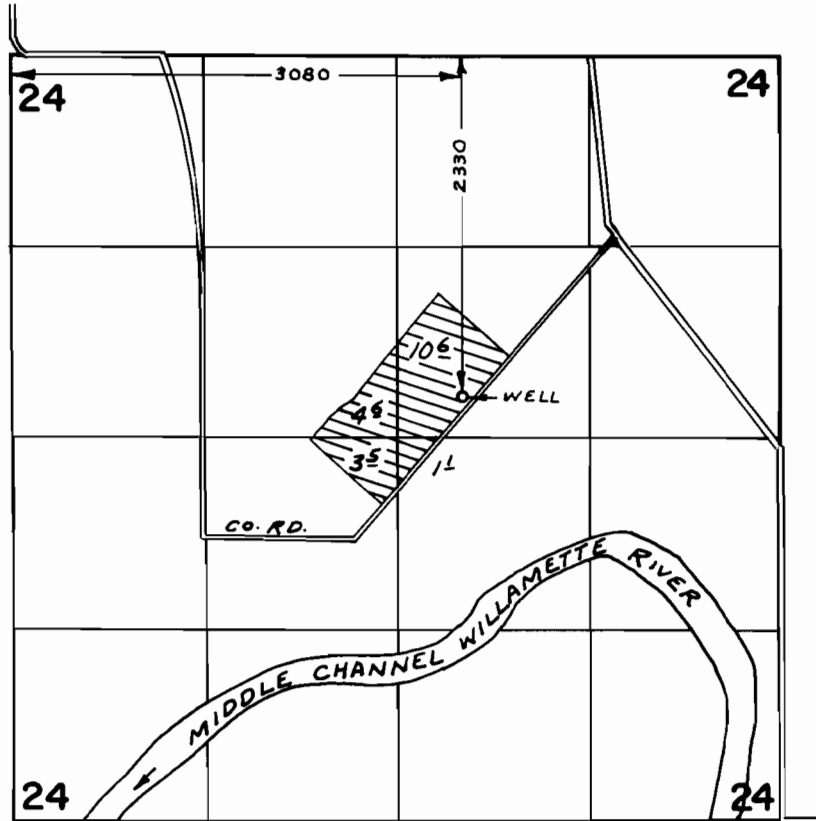

FINAL PROOF SURVEY UNDER

Application No. G-6615 Permit No. G-6196
IN NAME OF

LESLIE & MARGARET WHEELER

Surveyed AUG. 15, 1977, by BOB BARWIN