


T.11S.R.3 & 4 W.W.M.

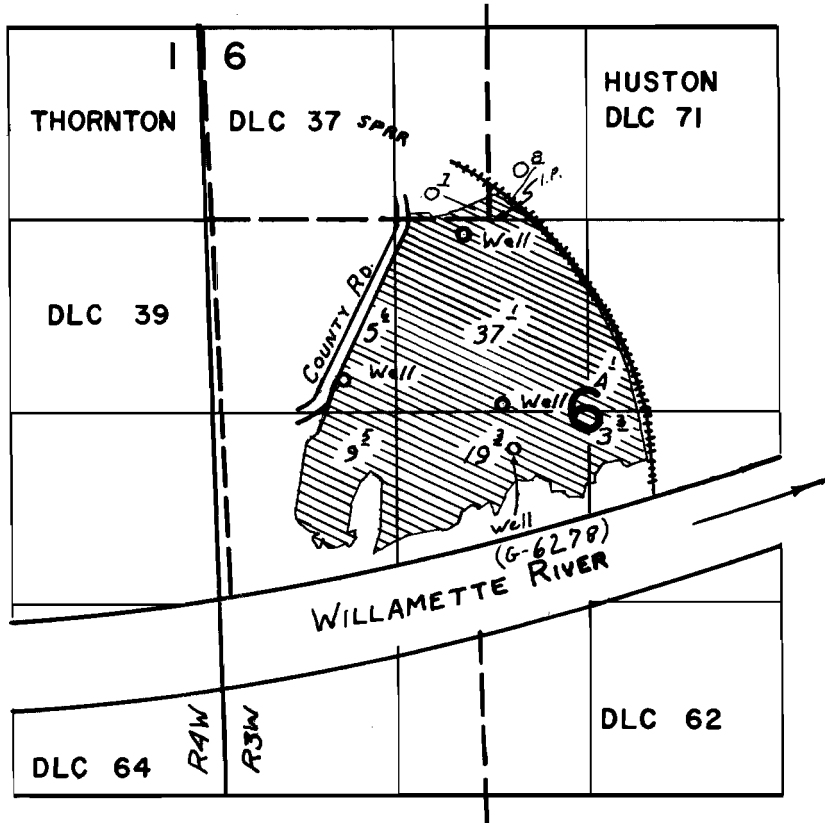

Wells located: 110 ft. S. & 70 ft. W.; 1120 ft. S. & 1000 ft. W.; and
 1280 ft. S. & 90 ft. E.; all from SE cor. Thornton DLC 37.
 1575 ft. S. & 150 ft. E.; from SE cor Thornton DLC 37.

FINAL PROOF SURVEY UNDER

Application No. G-3360 Permit No. G-3174
 IN NAME OF

ALBANY GOLF CLUB, INC.

Surveyed July 25 1969, by L. E. Gould
Mar. 31 1976, C. R. King