


T. 5 S., R. 2 E., W. M.

SECTION 25

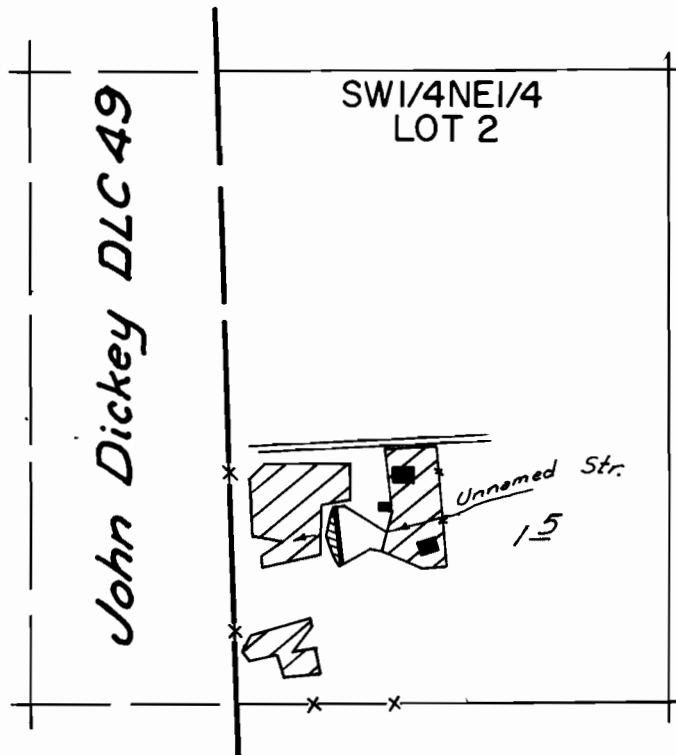

SCALE 1" = 400'

FINAL PROOF SURVEY
UNDER

Application No. R-47810 Permit No. R-5792
47811 35844
IN NAME OF

John Weygandt
Surveyed July 26, 1977 by AC Brown

PTS-1977-L