


T2S. R4E. WM.

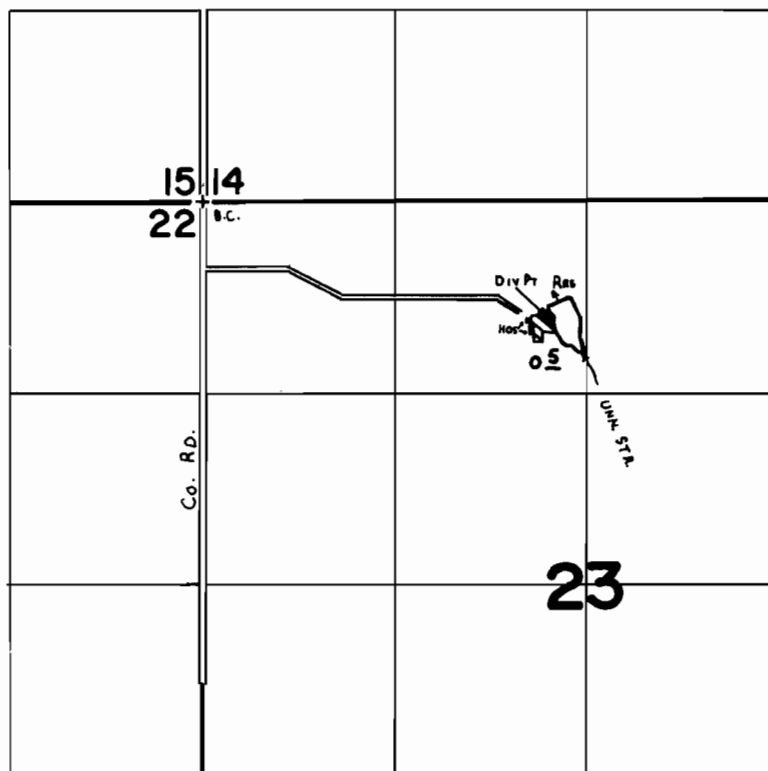

Div. Pt. Loc: 810' S. & 2375' E. fr. N.W. Cor. Sec. 23.

FINAL PROOF SURVEY
UNDER

Application No. 48477 Permit No. 36382
IN NAME OF

RICHARD PULLEN

Surveyed OCT. 11, 1978, by C. L. HUGHES