


# T. 4 S., R. 3 E., W.M.

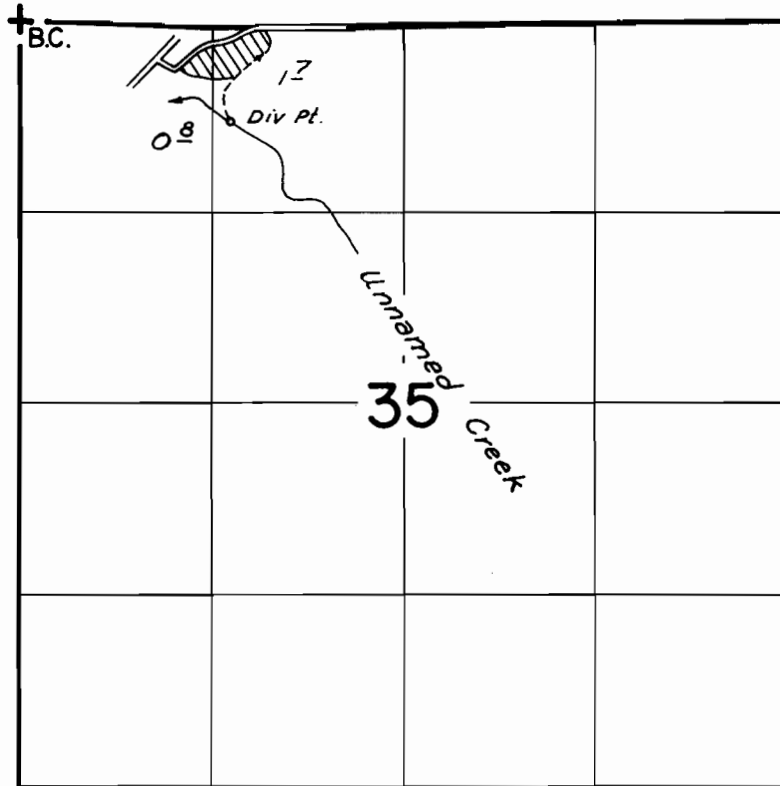

Div. Pt. Loc.: 700' S. & 1430' E. from NW Cor. Sec. 35

## FINAL PROOF SURVEY UNDER

Application No. 50523 Permit No. 38150  
IN NAME OF

Grear A. Casper

Surveyed July 28, 1977, by AC Brown