


T.8N.,R.9W.,W.M.

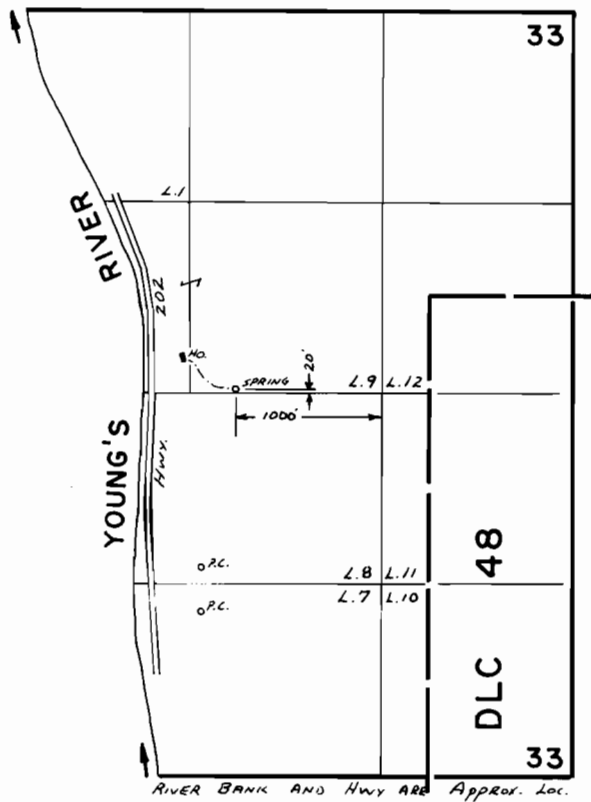

FINAL PROOF SURVEY UNDER

Application No. 51539 Permit No. 38885
IN NAME OF

CHARLES H. HOPKINS

Surveyed JUNE 24 1976, by L. Toll