


T.5N., R.9W., W.M.

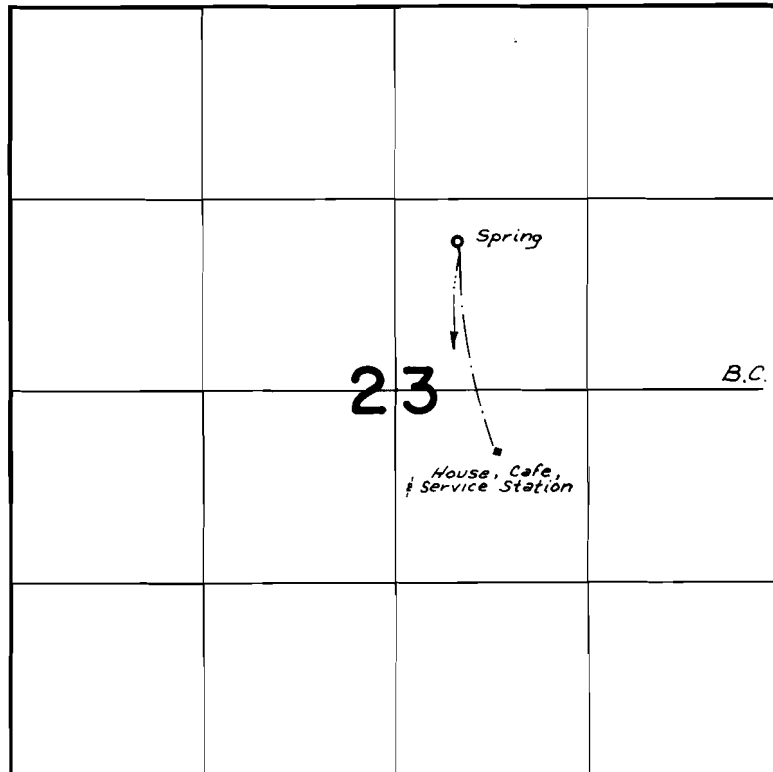

Spring Loc.: 1020' N. & 2210' W. from E $\frac{1}{4}$ Cor. Sec. 23

FINAL PROOF SURVEY
UNDER

Application No. 53200 Permit No. 39477
IN NAME OF

Richard H. Kidder

Surveyed Sept. 1, 1977 by AC Brown

PTS-1977-L