


T. 29 S. R. 4 W. W.M.

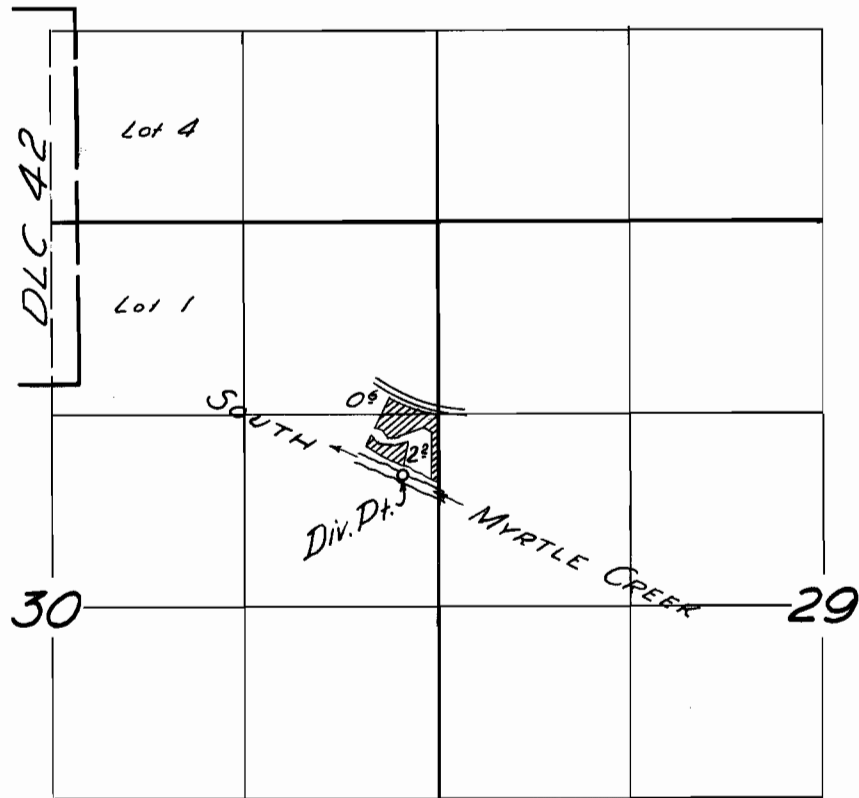

FINAL PROOF SURVEY

UNDER

Application No. 29071 Permit No. 22864

IN NAME OF

OTTO BENESH & RALPH SHOENEMAN

Surveyed 25 Sept. 1956, by [Signature]