


T.28S. R.7W. W.M.

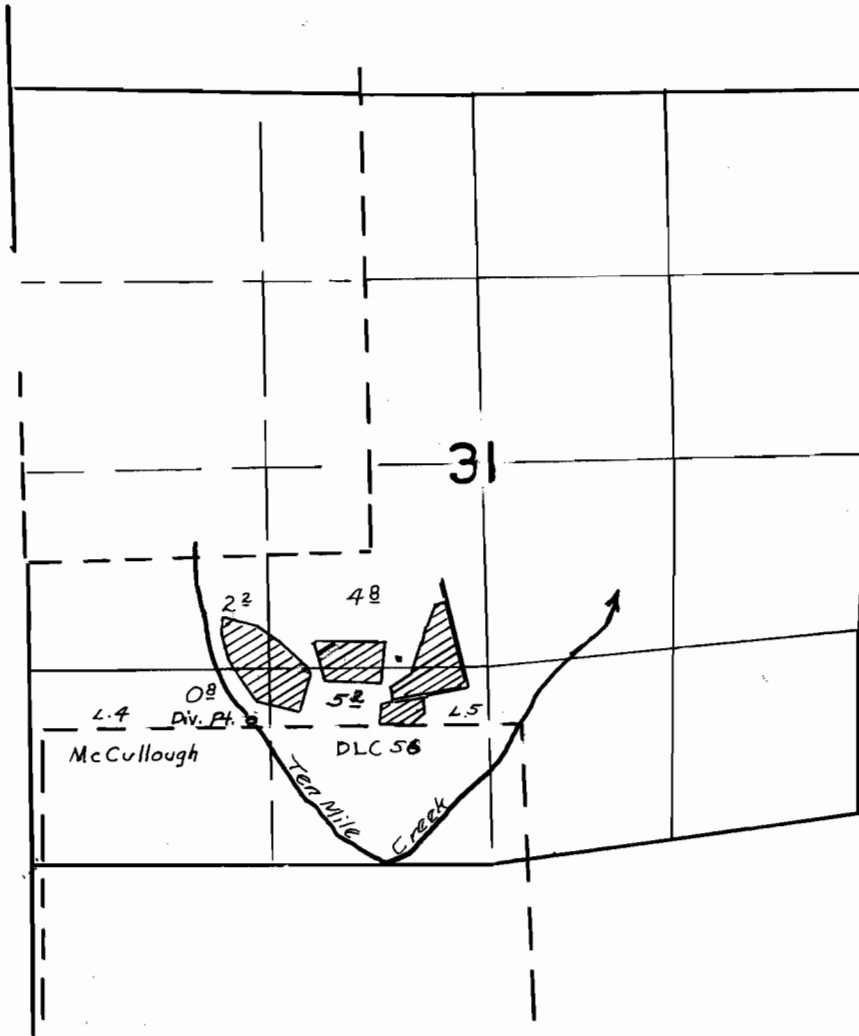

FINAL PROOF SURVEY
UNDER


Application No. 15505 Permit No. 11404
IN NAME OF

Glen S. Baughman

Surveyed Sept. 8, 1943, by Geo. V. Norderman

Superseded

T. 28 S., R. 7 W. W.M.

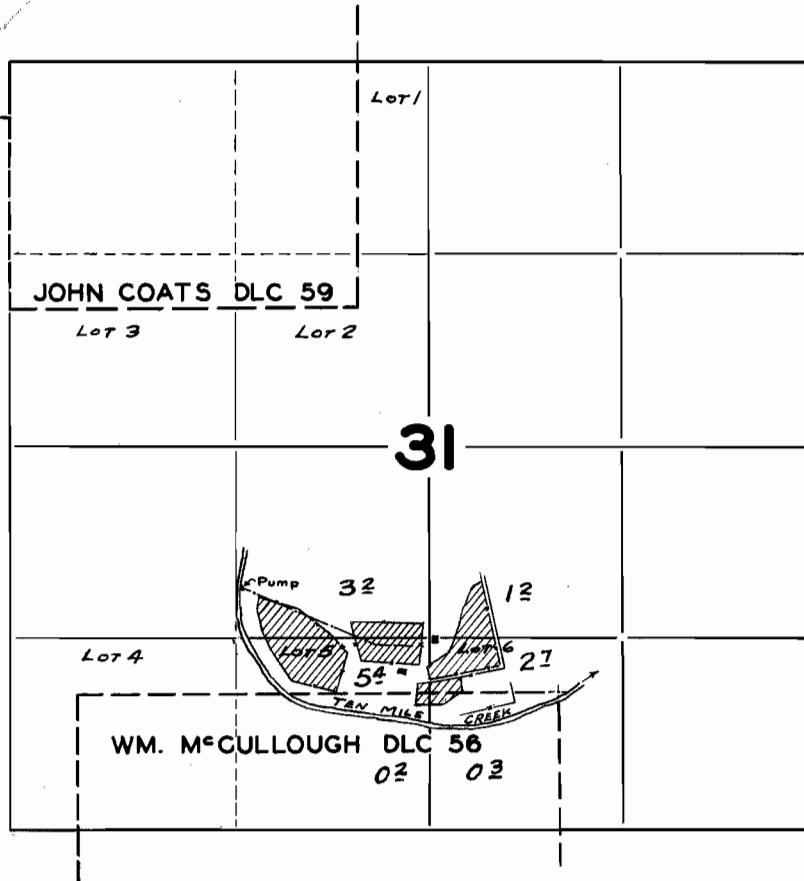

FINAL PROOF SURVEY
UNDER

Application No. 15505 Permit No. 11404

IN NAME OF

Grace Coats Godfrey

Surveyed Sept. 8, 1943, by Earl Pederman