


# T.13S.R.31E.W.M.

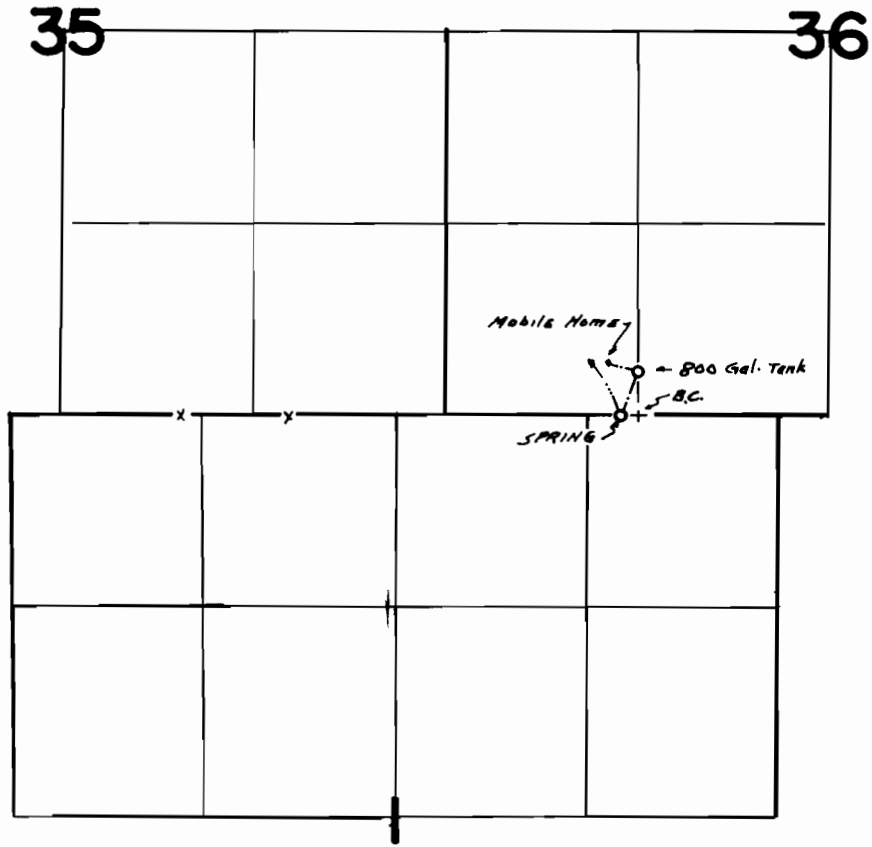

SPRING LOC. - 20' N + 1200' E From SW Cor. Sec. 36

## FINAL PROOF SURVEY UNDER

Application No. 53378 Permit No. 39862  
IN NAME OF

..... GLEN W. GODDARD .....

Surveyed Sept. 16, 1977, by S.C. BROWN.....