


G-6990
47278

SE $\frac{1}{4}$ of SEC 24 T 23 S R 33 E

1" = $\frac{1}{8}$ Mi.

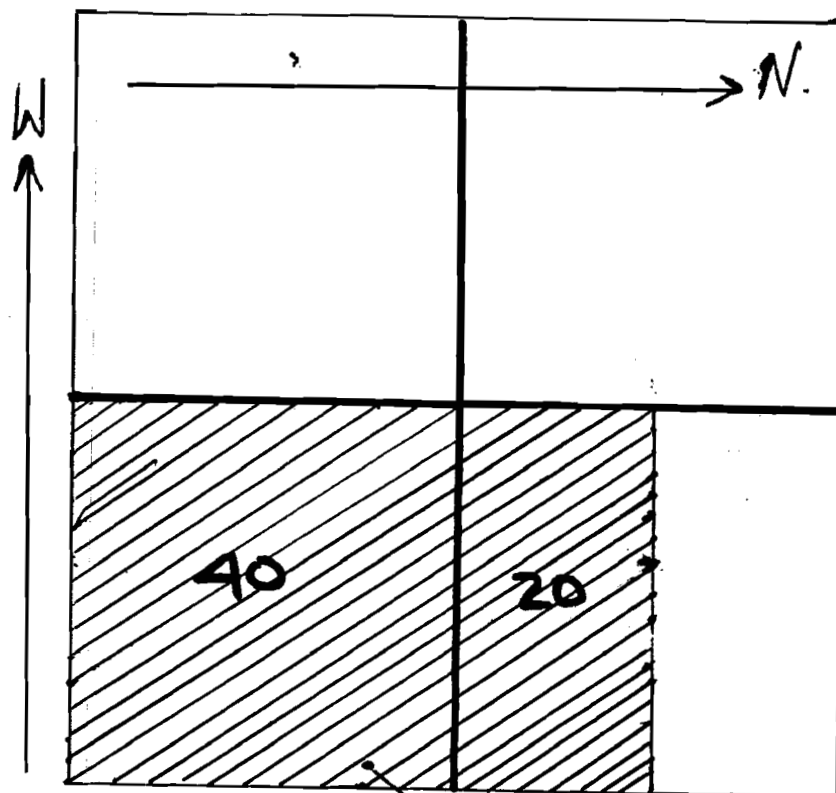

Application No. G-7513
Permit No. G 6990

RECEIVED

SEP 13 1976

WATER RESOURCES DEPT
SALEM, OREGON

WELL SITUATED 990 FT N AND 100 FT W
OF SE CORNER OF SEC 24 T 23 S R 33 E