


T.36 S.R.4 W.W.M.

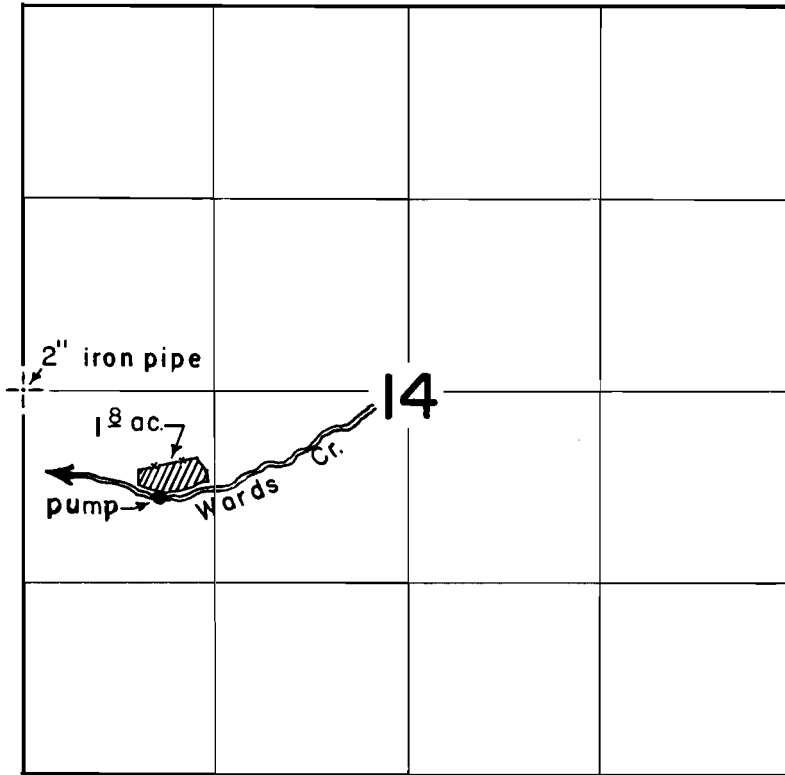

FINAL PROOF SURVEY UNDER

Transfer No. G-56

Application No. _____ Permit No. _____


IN NAME OF

W.C. & Mabelle Green

Surveyed July 21, 1966, by DC. Hendrix

ALL RIGHTS RESERVED
SALEM, OREGON

T.36S.R.4W.W.M.

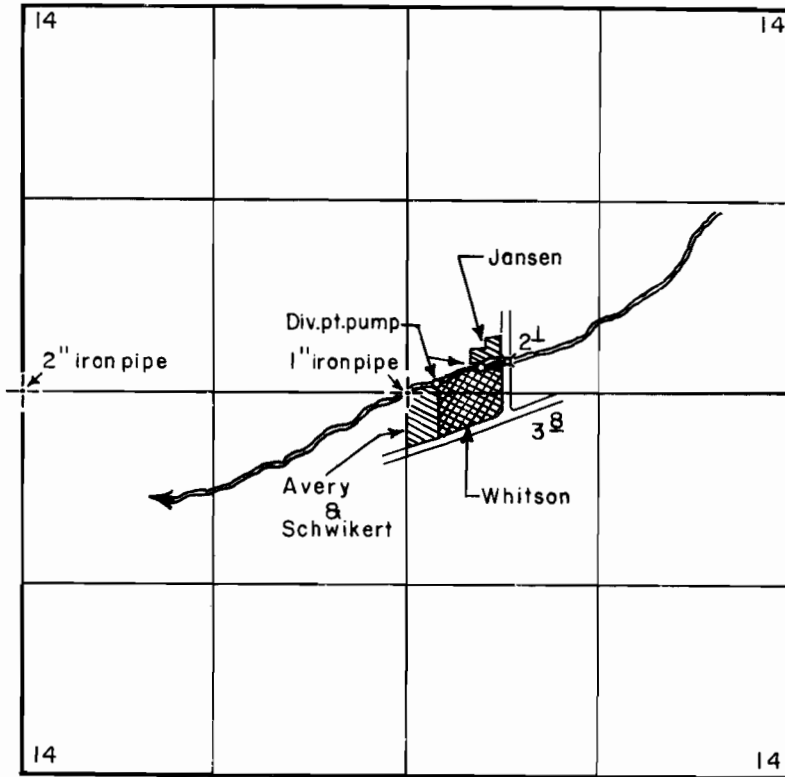

FINAL PROOF SURVEY UNDER

Application No. _____ Transfer no. T-59
Permit No. _____
IN NAME OF

_____ W. H. & Marie Tenney _____

Surveyed July 21, 1966, by D.C. Hendrix _____