


T.38 S.R.3 W.W.M.

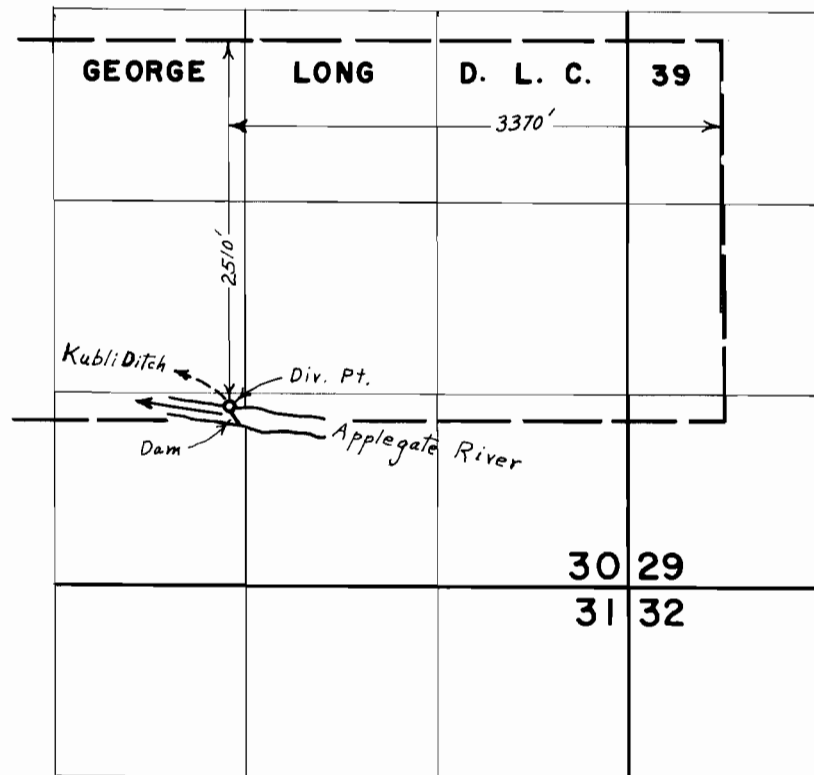

FINAL PROOF SURVEY
UNDER

Application No. _____ Transfer No. H-160
Permit No. _____
IN NAME OF
KUBLI DITCH

Surveyed July 28, 1967, by L. E. Gould