


T.35&36S.,R.1W.,W.M.

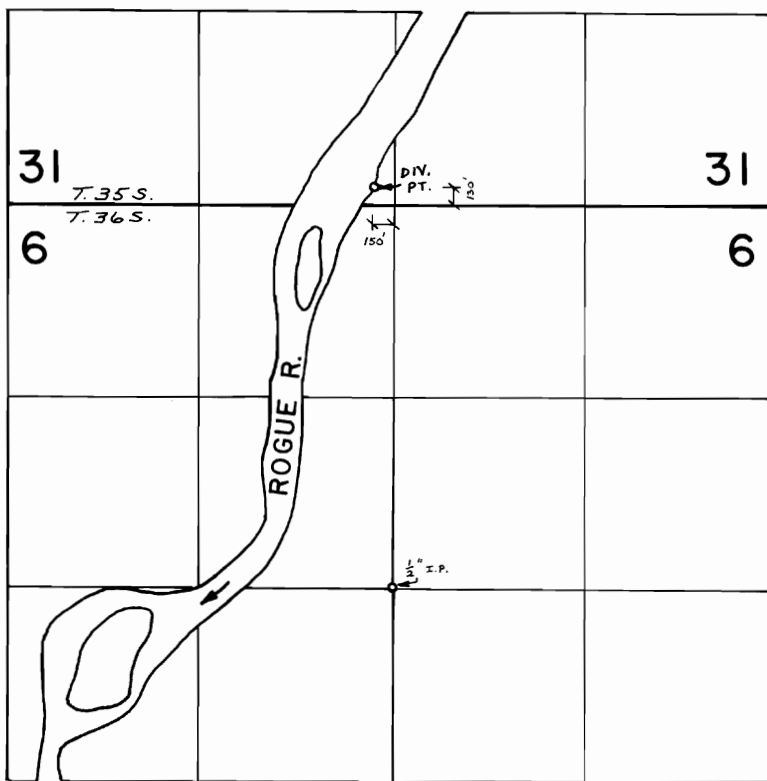

FINAL PROOF SURVEY
UNDER

Application No. TR-2956 Permit No.
IN NAME OF

HERMAN HUEBNER

Surveyed AUG. 22 1978, by B. SUND