


T. 35 S., R. 6 W., W.M.

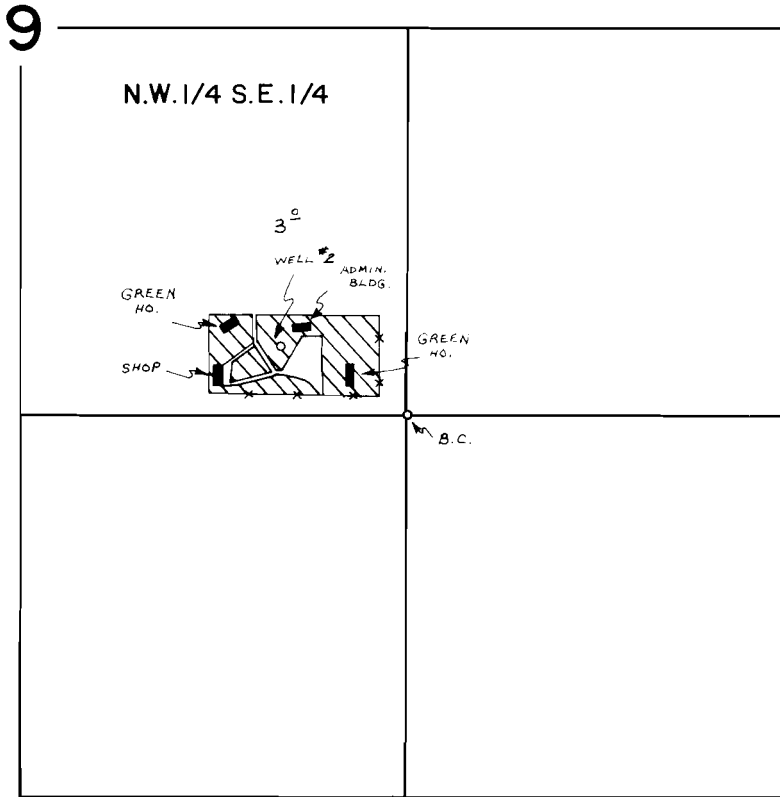

WELL LOC.: 230' N. & 430' W. FROM S.E. COR., N.W. 1/4 S.E. 1/4, SEC. 9.

SCALE: 1" = 660'

FINAL PROOF SURVEY UNDER

Application No. G-5363 Permit No. G-5299
IN NAME OF

BUREAU OF LAND MANAGEMENT

Surveyed DEC. 7 1977, by B. SUND