


T.17S. R.6W. W.M.

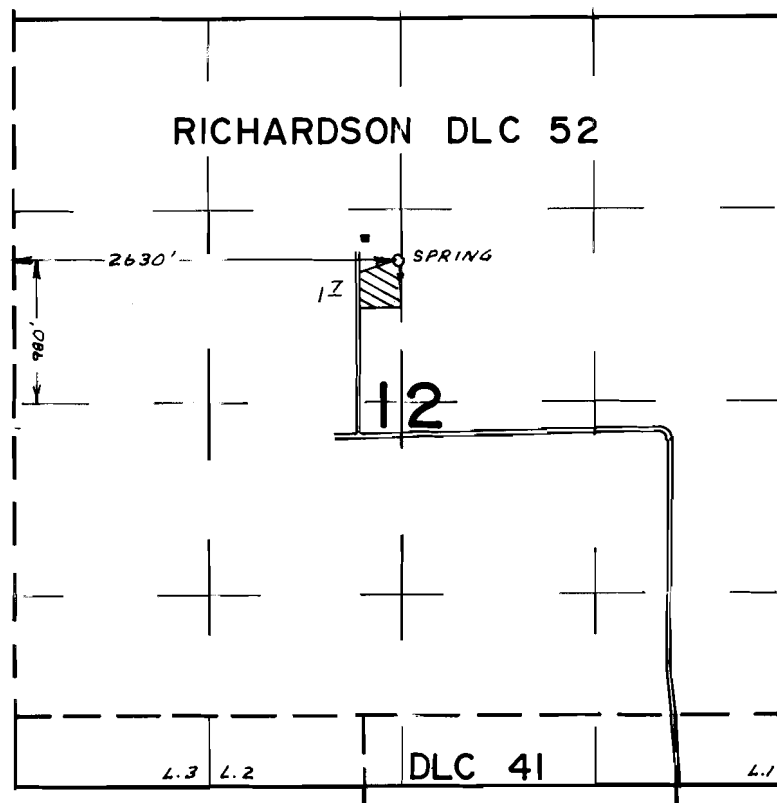

FINAL PROOF SURVEY
UNDER

Application No. 50727... Permit No. 37385...
IN NAME OF

STANLEY L. & FLORENCE M. THOMAS

Surveyed MAY 3... 1976, by L.H. NUNN...