


T.12S.R.11W.W.M.

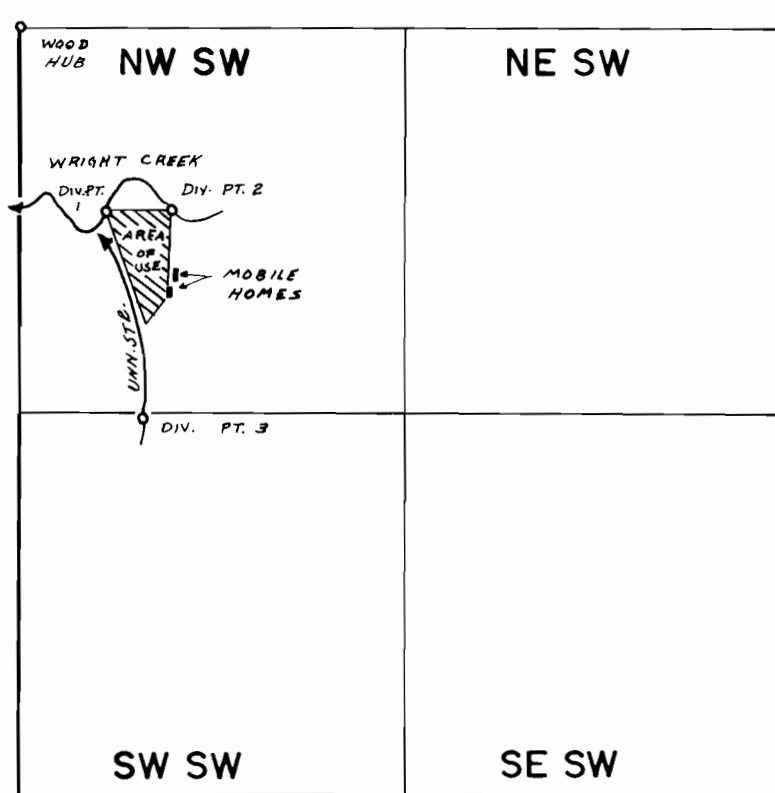

DIV. PTS. LOC. - #1 - 630'S ± 290'E, #2 - 630'S ± 520'E, #3 - 1340'S ± 420'E,
ALL FROM W 1/4 COR. SEC. 1

SCALE - 1" = 660'

FINAL PROOF SURVEY UNDER

Application No. **49591** Permit No. **36097**
IN NAME OF

OREGON AQUA-FOODS, INC.

Surveyed Aug. 12, 1976, by D. NORBY