


T.IIS. R.IIW. W.M.

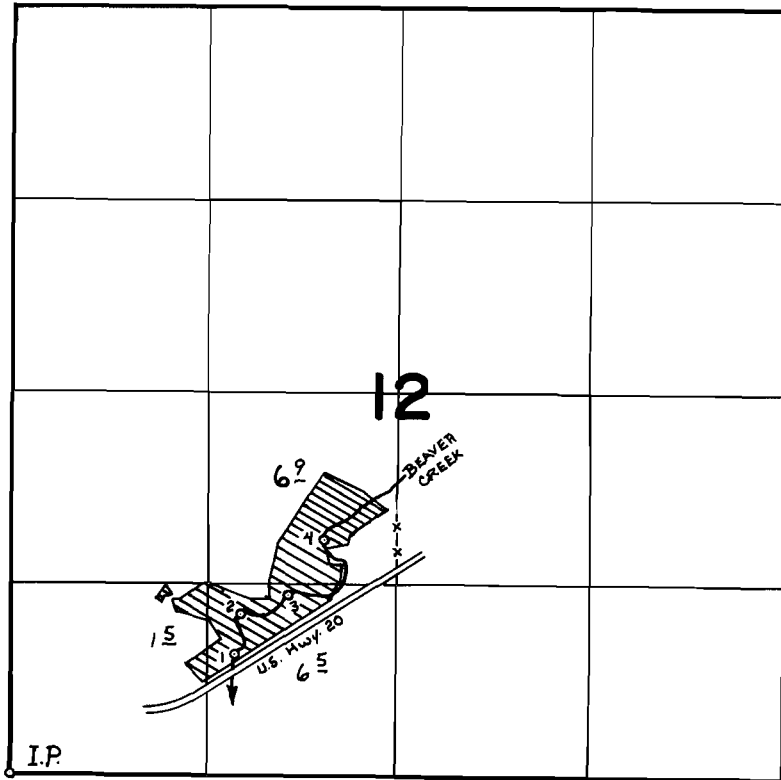

Div. Pts. Located: 1-825' N & 1525' E 2-1100' N & 1575' E
3-1250' N & 1900' E 4-1625' N & 2150' E
all from SW cor Sec. 12

FINAL PROOF SURVEY

UNDER

Application No. 50713 Permit No. 38303
IN NAME OF

LESTER G. McALPINE

Surveyed OCT. 25 1977, by J.S.DONALDSON