


T.9S., R.10W., W.M.

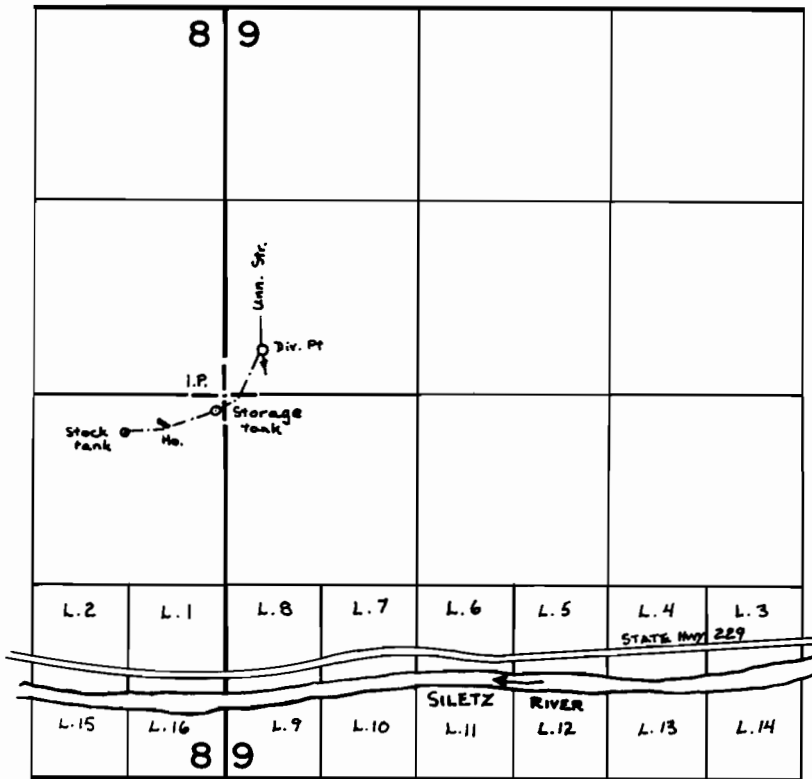

Div. Pt. Located 300' N & 250' E from the W $\frac{1}{4}$ cor. Sec. 9

FINAL PROOF SURVEY

UNDER

Application No. 51145 Permit No. 38658
IN NAME OF

WILFRED R. GERTULLA

Surveyed OCT. 26 1977, by J. S. DONALDSON