


T.13S.R.IE.W.M.

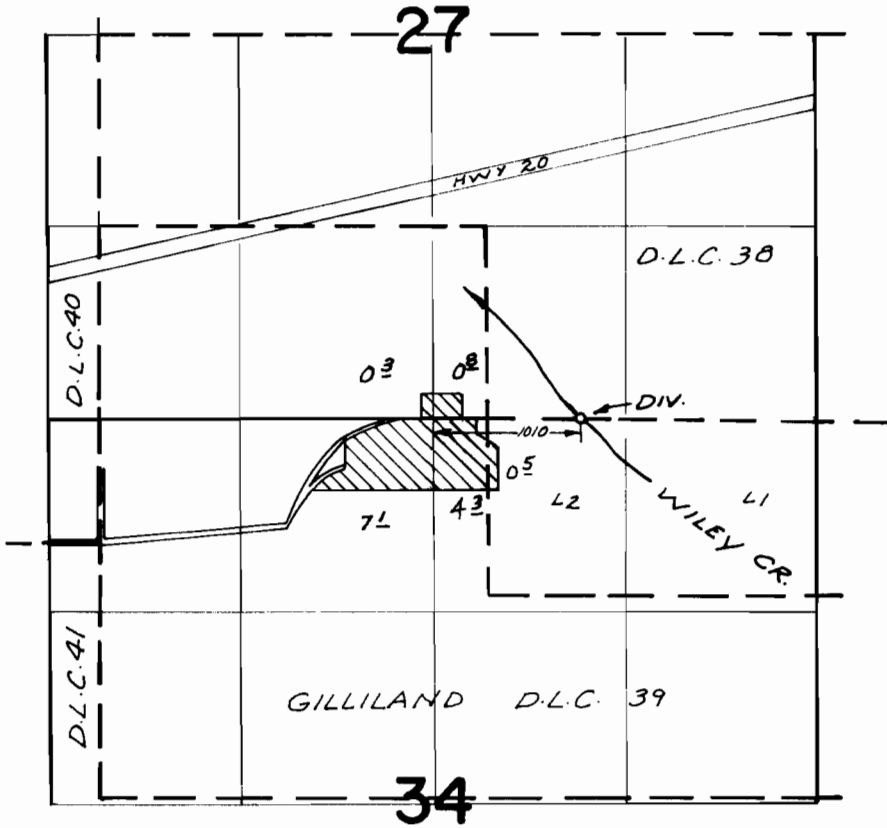

FINAL PROOF SURVEY
UNDER

Application No. 46649 Permit No. 34855
IN NAME OF

SWEET HOME CEMETERY MAINTENANCE DISTRICT

Nov. 9, 1977 J.S. DONALDSON
Surveyed MAY 11, 1973, by R. MUCKEN