


T. 18  $\frac{1}{2}$  19 S., R. 46 E., W.M.

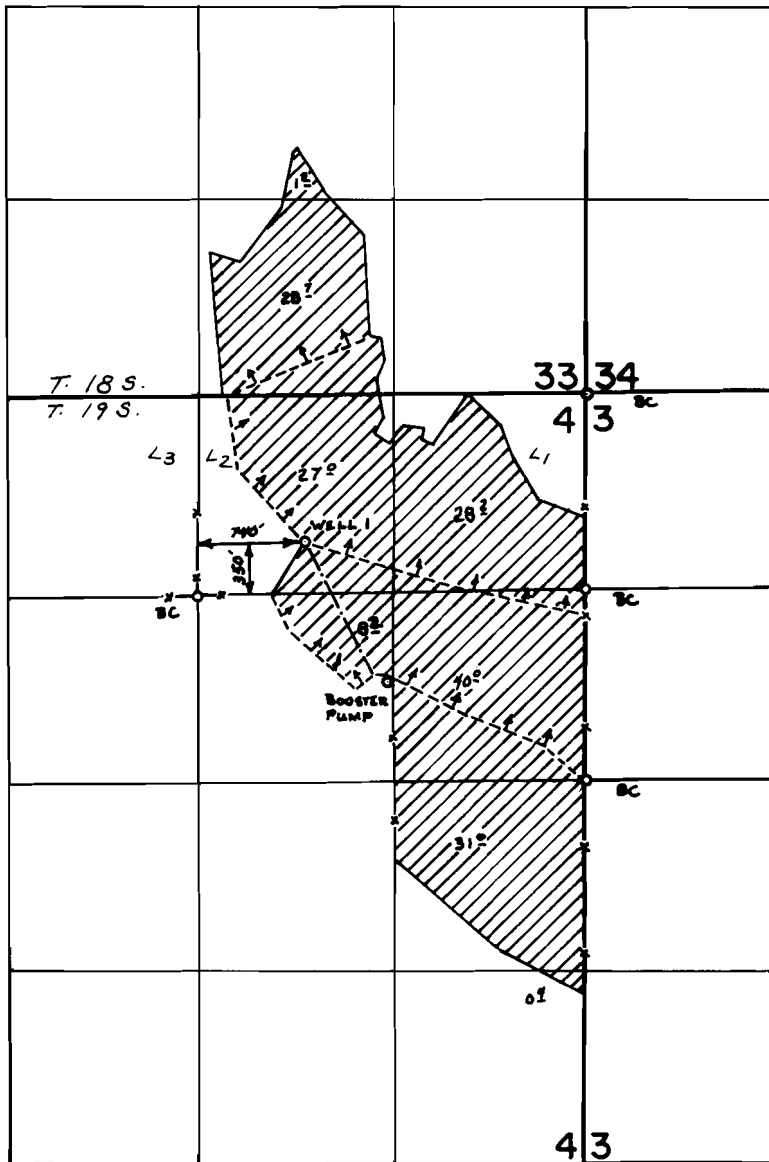

**FINAL PROOF SURVEY**  
UNDER

Application No. G-5631 Permit No. G-5463  
IN NAME OF

RAYMOND FINDLEY

Surveyed OCT. 15 1977, by J.S.DONALDSON