


T.10S.,R.2W.,W.M.

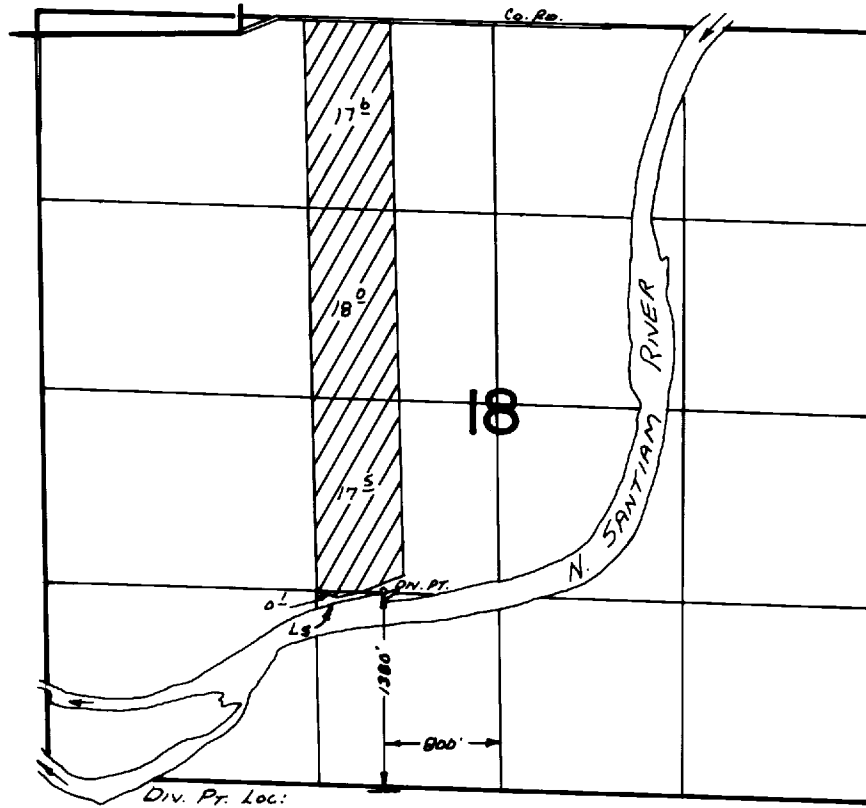

FINAL PROOF SURVEY
UNDER

Application No. 50519... Permit No. 38147...
IN NAME OF

E. CLINTON HART

Surveyed July 7, 1976, by L. Toll