


T.6S.,R.1E.,W.M.

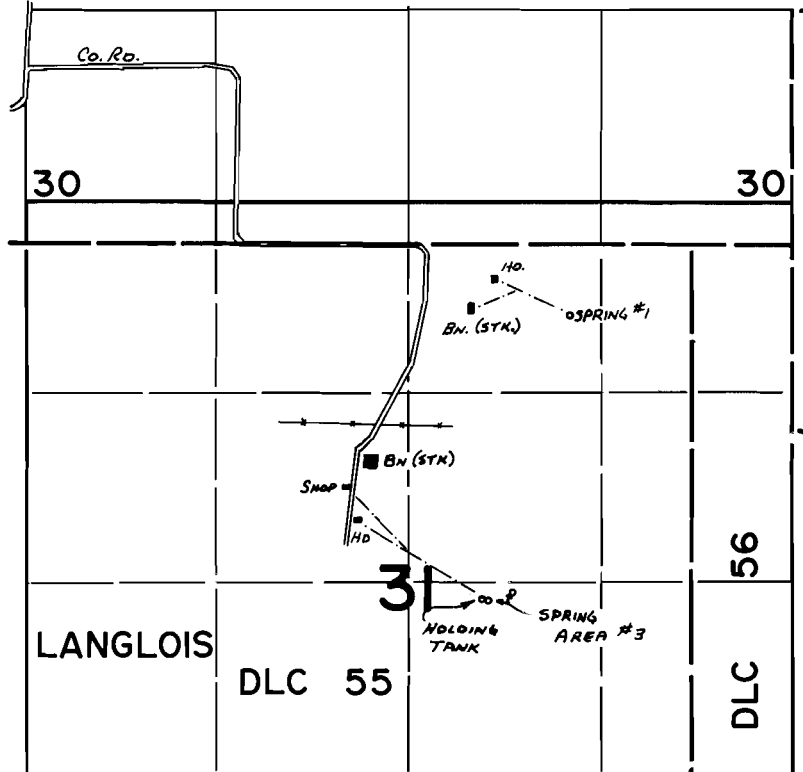

SPRING #1 (PER. 38148) - 780'S AND 1100'E FROM N 1/4 COR. SEC 31
 SPRING AREA #3 (PER. 38149) - 120'S AND 620'E FROM C 1/4 COR. SEC 31

FINAL PROOF SURVEY UNDER

50520 38148
 Application No. 50521 Permit No. 38149
 IN NAME OF

ROGER LOE

Surveyed Aug. 12, 1976, by L. Toll