


T.6S. R.2W. W.M.

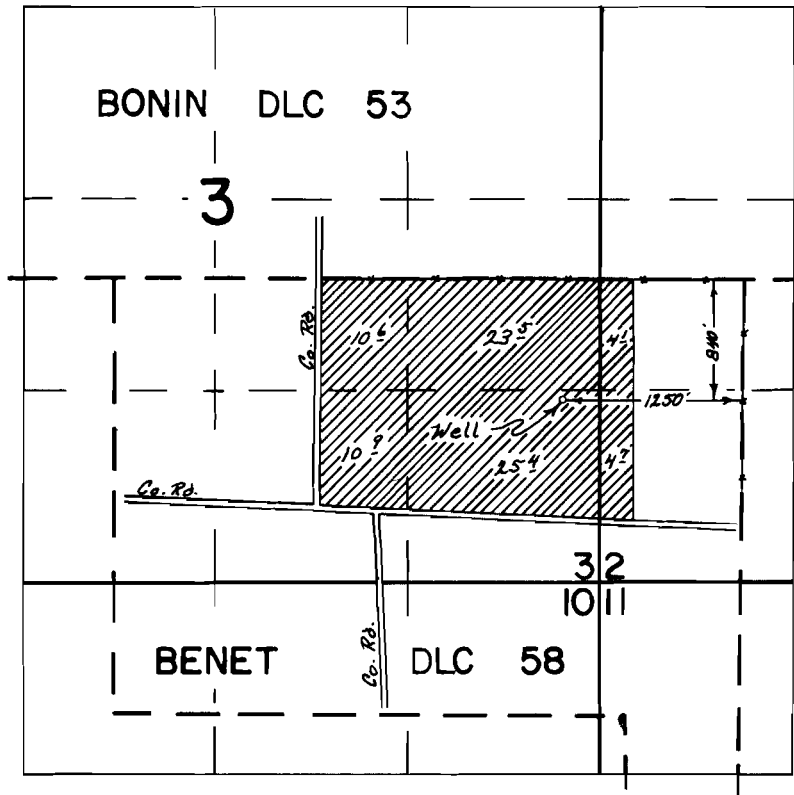

FINAL PROOF SURVEY UNDER

Application No. 6-4193 Permit No. 6-3958
IN NAME OF

JAMES HOLLIN

Surveyed May 18 1972, by R. B. Mucker