


# T.9S.R.5W.W.M.

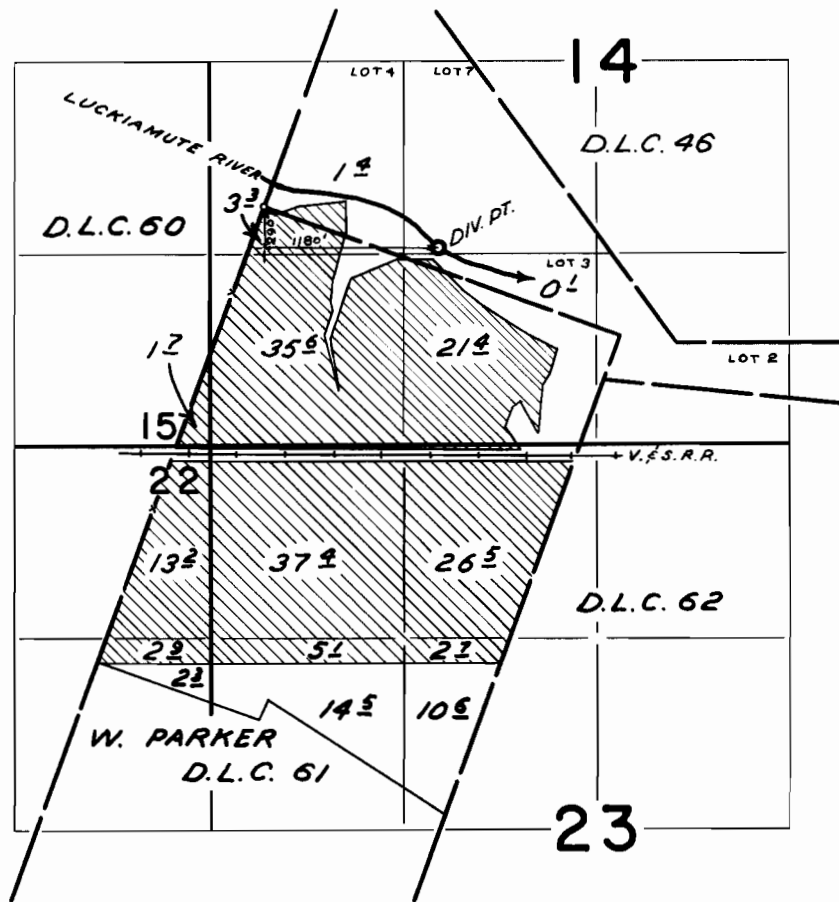


## FINAL PROOF SURVEY UNDER

Application No. 37335 Permit No. 27812  
IN NAME OF

**Stephen Benedict**

Surveyed Aug. 4 1965, by C. GARDNER

9S 5W

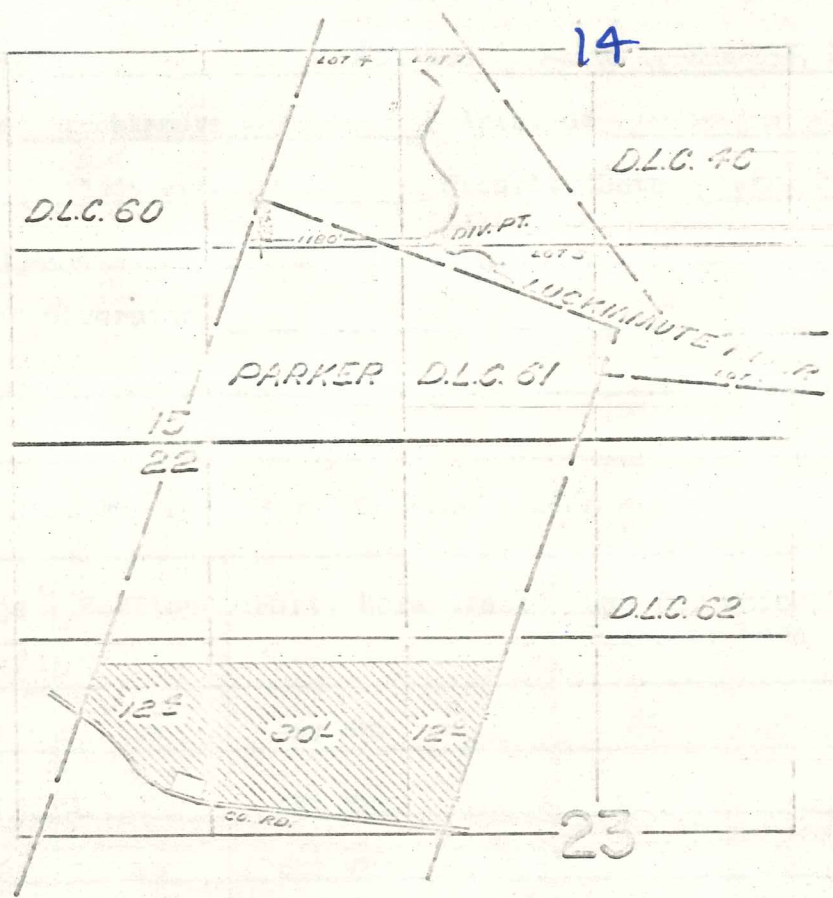

FINAL PROOF SURVEY  
UNDER

Application No. 41793 Permit No. 31207  
IN NAME OF

STEPHEN BENEDICT

Surveyed MAR. 25 1969 by D.R. BUELL