


T.2S.R.44E.W.M.

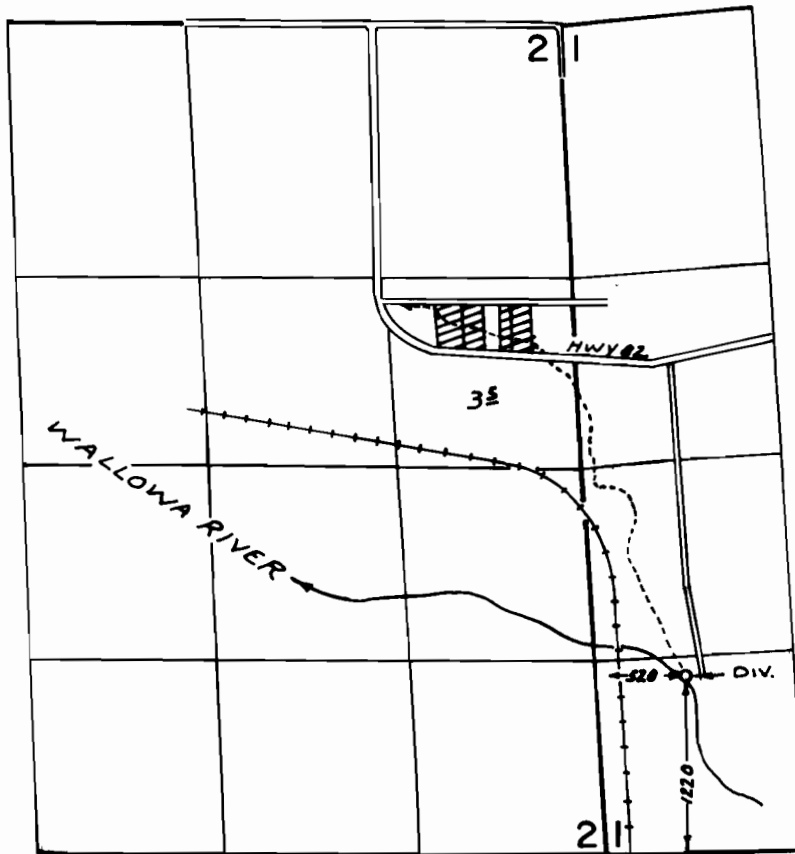

FINAL PROOF SURVEY
UNDER

Application No. 52760 Permit No. 39719
IN NAME OF

DONALD MAXWELL, KELSIE MAKIN, W. F. MAKIN & R. S. GILBERT

Surveyed SEPT. 22 1976, by R. MUCKEN